


SECTION 25 TOWNSHIP 31 RANGE 32W

WELL NO. #1 Sutton

COMPANY King-Stevenson

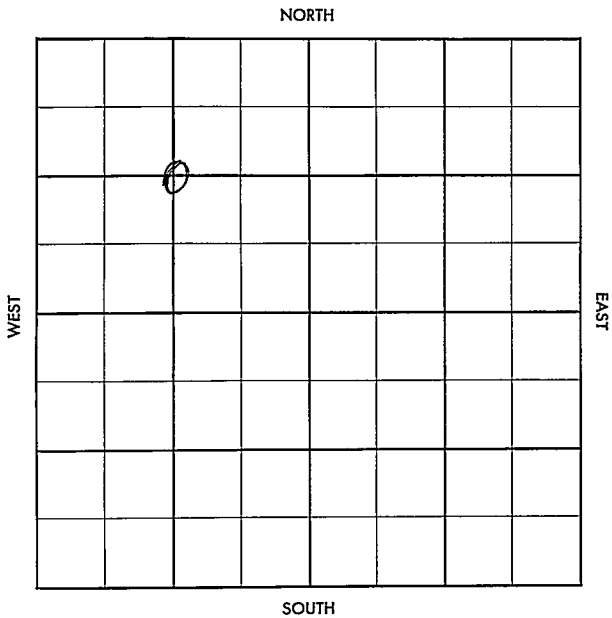


County Seward Elev. _____
 Sec. 25 Twp. 31 Rge. 32W
 Company King-Stevenson
 Farm Name Sutton No. 1

TOPS	DEPTH	LOG	DATUM
Anh.			
Tp.			
H.			
Tr.			
Dg.			
Bl.			
L.			
K.C.			
B.K.C.			
Ce.			
C.			
M.			
M.			
K.			
Mz.			
Mo.			
V.			
S.			
S.			
A.			
R.			
PE.			
G.			
TD.			

Loc. in Sec. _____
 C NW
 Geol. _____
 Contr. _____
 Pool
 Hugoton

Graham-Michaelis Tool

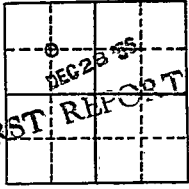

Date Comm. 12-15-56 Ohio (FO)
8" @ 562 w/300, RTD 2744, 5" @ 2735 w/300

WOC

~~Handwritten signature or scribble~~

Co.

1/6

No.

Sec.

T.

R.

