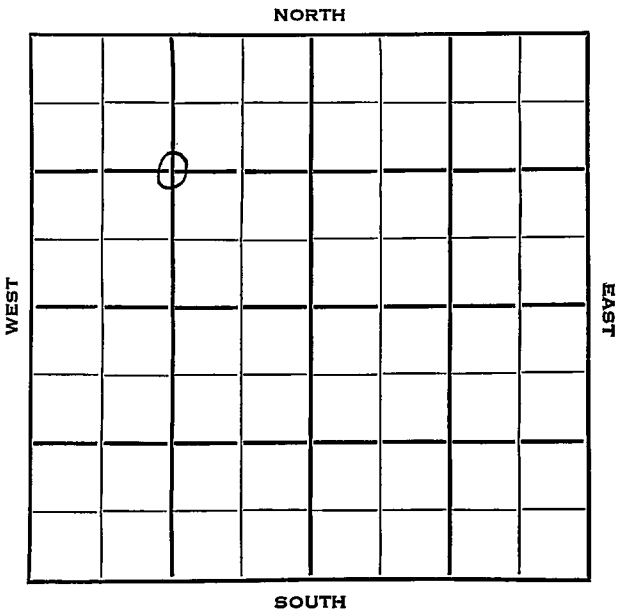


Section 25 Township 31 Range 16WWell No. #1 SchuetteCompany Barbara Oil

Comanche

KANSAS ✓

Sec. 25 Twp. 31 R. 16WWell No. #1Schuette FarmBarbara Oil

Company

Patton

Contractor

Robbins Pool1320

Ft. from N. Line


Ft. from S. Line

Ft. from E. Line

1320

Ft. from W. Line

C NW/4

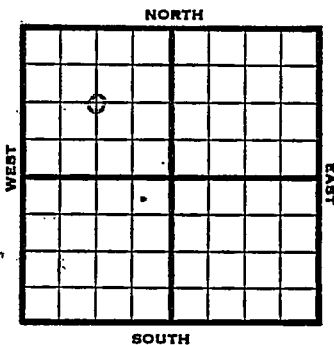

1953

Elev. 2051' REPORT

8/19

Spud 8-17-53
10" @ 521, WOC

8/26

Drlg. 3065'

9/2

Drlg 4496'

9/9

Spud 8-17-53

D & A

TD 5000'


10" @ 521'

Heeb. 4150, Br. Lime 4322, Lans 4344,
Kemiska 4812, Miss 4920

TD 5000'

D & A

ABANDONED

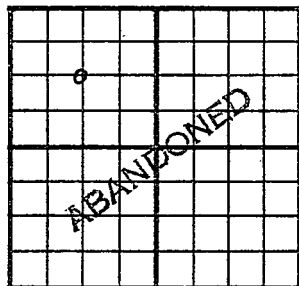County Comanche State KansasSec. 25 (Blk.
Twp.) 31 (Sur.
Rge.) 16W Map No.Operator Barbara OilWell No. 1 Farm SchuetteElev. 2051 Location C NW/41320Ft. From N Line NW1320Ft. From W Line Quarter1st. ReportCompletion SEP 9 1953Remarks Robbins PoolPatton - Contr.Spudding Date 8-17-53Drilg. Data D & A TD 500010" @ 521 Heeb. 4150 Br. lime 4322Lans. 4344 Kemiska 4812 Miss. 4920TD 5000D & A

