

Section 26 Township 31 Range 9WWell No. #1 BroceCompany Purcell & Mull
p

NORTH

WEST

EAST

							0

SOUTH

Harper KANSAS

SEC.	TWP.	R.
26	31	9W

WELL NO.

1 Broce

FARM

COMPANY

Purcell & Mull

CONTRACTOR

Co. Tools

Grabs Pool

Ft. from N. Line


990

Ft. from S. Line

330

Ft. from E. Line

Ft. from W. Line

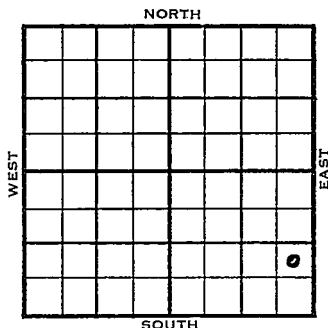

NE SE SE

Carter FO

1955


ELEVATION

REPORT

3/2

Spud 2-27-55
8" @ 214'
Drlg. 1365'

County Harper State Kansas
 Sec. 26 (Blk.) 31 (Sur.) 9W Map No.
 Operator Purcell & Mull
 Well No. 1 Farm Broce
 Elev. _____ Location NE SE SE

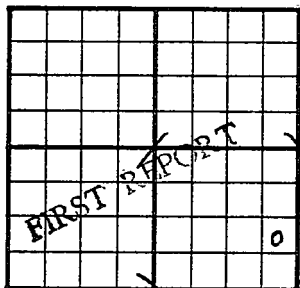

990ft. From S Line SE
330ft. From T Line Quarter
1st. Report MAR 2 1955
Completion
Remarks Carter FO
Co. tools
Spudding Date 2-27-55

Drlg. Data Grabs Pool
8" @ 214 drlg. 1365

FABEN GILSTRAP