


KANSAS StevensSection 26 Township 31 Range 38WWell No. 1 CoxonCompany Panhandle Eastern

Hugoton

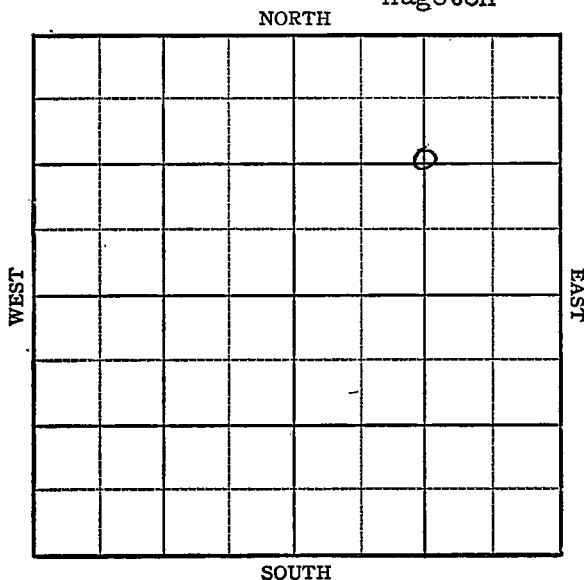

Sec. 26 Twp. 31 R. 38-W

Well No. #1 Coxen Farm
Panhandle Eastern Company
Hugoton


1320 Ft. from N. Line

_____ Ft. from S. Line

1320 Ft. from E. Line

_____ Ft. from W. Line

C NE

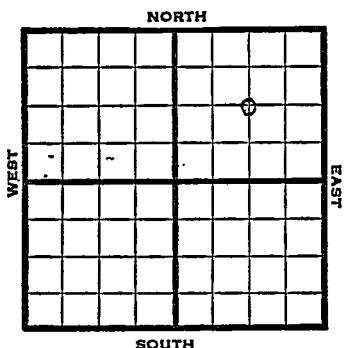

1949

Elev 3148' REPORT

1/26

10" @ 692

Drilg 2305'

2/2

TD 2465'

7" @ 2454'

2/9

TD 2465

7" @ 2454'

2/16

TD 2676'

233' of 5" Perf liner @ 2676'

2/23

TD 3676'

7" @ 2454'

233' of 5" Perf

Line @ 2676'

21000 acid

8,707,000 Gas

387# R Pr.

Comp

COMPLETED

Map No. _____ Sec. 26 Twp. 31 R. 38WWell No. 1 Coxon

Panhandle Eastern

Company

FIRST REPORT

Contractor

C NE

SECTION PLAT

1320 Ft. from N. Line

_____ Ft. from S. Line

1320 Ft. from E. Line

_____ Ft. from W. Line

Stevens County

Location _____

Rig up _____

Drilling and Remarks:

10" @ 692

drlg. 2305

RECORD

Cased _____ in., _____ ft.

Sand _____

Gas _____

Oil _____

Total Depth _____

PRODUCTION

1st 24 hrs. Nat. _____

1st 24 hrs. after shot _____

Gas _____ Cu. Ft.

Dry Hole _____

Abandoned _____

Date

JAN 26 1949 19S. J. LEWIS Scout

Map No. _____ Sec. 26 Twp. 31 R. 38W

Well No. 1 Coxon

Panhandle Eastern Company

COMPLETE Contractor

C NE


E 13148
SECTION PLAT

1320 Ft. from N. Line

_____ Ft. from S. Line

1320 Ft. from E. Line

_____ Ft. from W. Line

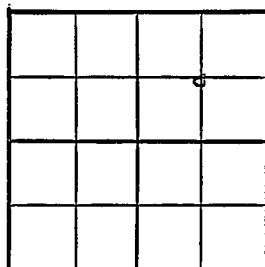

STEVENS CO (Coil)
Hugoton Pool

Location _____

Rig up _____

Drilling and Remarks:

7" C 2454
233' by 5" Pay
line C 2676
21000 cu ft
8,707,000 gal
387 = R/2

RECORD

Cased _____ in., _____ ft.

Sand _____

Gas _____

Oil _____

Total Depth 2676

PRODUCTION

1st 24 hrs. Nat. _____

1st 24 hrs. after shot _____

Gas _____ Cu. Ft.

Dry Hole _____

Abandoned _____

Date

FEB 23 1949

19

S. J. LEWIS

Scout