

Sec. 26 Twp. 31 R. 37W

Well No. #1 Brewer Farm

Republic Natural Gas Company

Hugoton


100 Ft. from N. Line

 Ft. from S. Line

100 Ft. from E. Line

 Ft. from W. Line

NE SW

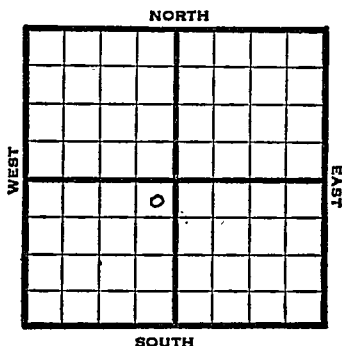

1947

Elev. 3087' REPORT

8/27 10" @ 577'
Drlg. 2120'

9/3 "

9/10 TD 2576'
7" @ 2543'
RUST

9/17 "

9/24 "

10/1 "

10/8 232' of 5" Perf liner @ 2769'

10/15 "

10/22 9500 acid

10/29 7" @ 2543'
232' of 5" Perf liner @ 2769'
13,000 Acid
3,968,000 Gas
TD 2769'
416# RPr

COMPLETED

Map No. _____ Sec. 26 Twp. 31 R. 37W

Well No. 1 Brewer

Republic Natural Gas Company

1ST REPORT

Contractor

NE SW

7
r

SECTION PLAT

		o	

100 Ft. from N. Line

Ft. from S. Line

100 Ft. from E. Line

Ft. from W. Line

Stevens County

Location

Rig up

Drilling and Remarks:

10" @ 577

drlg. 2120

RECORD

Cased _____ in., _____ ft.

Sand _____

Gas _____

Oil _____

Total Depth _____

PRODUCTION

1st 24 hrs. Nat. _____

1st 24 hrs. after shot _____

Gas _____ Cu. Ft.

Dry Hole _____

Abandoned _____

Date

AUG 27 1947 19

S. J. LEWIS

Scout

Map No. 1 Sec. 26 Twp. 31 R. 37W

Well No. 1 Brewer

Republic Natural Gas Company

COMPLETE

Contractor

NE SW

E1,3087


SECTION PLAT

100 Ft. from N. Line

 Ft. from S. Line

100 Ft. from E. Line

 Ft. from W. Line

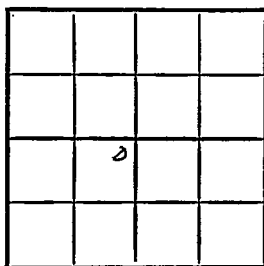

Stevens County

Location

Rig up

Drilling and Remarks:

7" @ 2543
232' of 5" Payline
@ 2769
13000 @ 2769
8,968,000 gal
#16 # RPE

RECORD

Cased in, ft.

Sand

Gas

Oil

Total Depth 2769

PRODUCTION

1st 24 hrs. Nat.

1st 24 hrs. after shot

Gas Cu. Ft.

Dry Hole

Abandoned

Date

OCT 29 1947

19

S. J. LEWIS

Scout