
KANSAS
FORM 51 5M 6-46 PETROL

Stevens county

Section 26 Township 31 Range 35-W

Well No. #1, Barnes

Company Derby et al

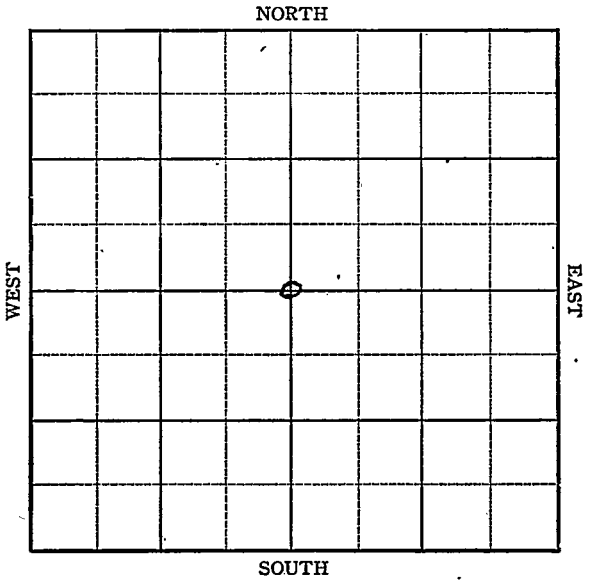

FORM 252-A
5M-6-46 PETROL

KANSAS

Sec. 26 Twp. 31S R. 35-W

Well No. #1 Barnes Farm

Derby et al Company


2640' Ft. from N. Line

Ft. from S. Line

2640' Ft. from E. Line

Ft. from W. Line

C Sec.

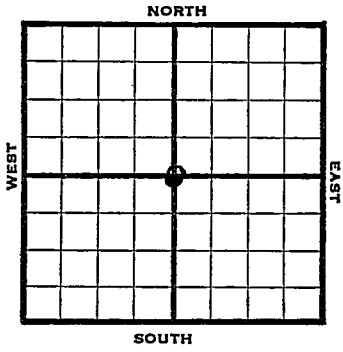

1946 2980 REPORT

9/5 Location
9/10 RUR
9/18 10" @ 590'
TD 2336
7" @ 2332 RUST
9/24 7" @ 2576 RUST
10/1 " "
10/8 " "
10/15 " "
10/22 " "
10/29 " "
11/6 Drlg 2660'
11/12 1000 acid
Drlg 2661'
11/20 TD 2776, 2 M gas
11/27 258' of 5" Perf liner @ 2786-
2000 acid
12/3 550 acid
12/10 "
12/17 "

1947
1/2 7" @ 2576'
TD 2776'
258' of 5" Perf Liner @ 2786'
25000 Acid
1,315,000 Gas
412# RPR

COMPLETED

FORM 56 200 BKS. 1-44 PETROL

Kansas Pool Name Hugoton

KANSAS

Map No. Sec. 26 Twp. 31 R. 35W

Well No. 1 Barnes

Derby etal. Company

FIRST REPORT Contractor

C Sec.

2640 Ft. from N. Line


Ft. from S. Line

2640 Ft. from E. Line

Ft. from W. Line

Stevens County

SECTION PLAT

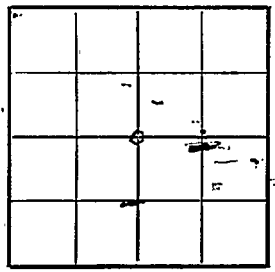

Location x

Rig up

Drilling and Remarks:

RECORD

Cased in., ft.

Sand

Gas

Oil

Total Depth

PRODUCTION

1st 24 hrs. Nat.

1st 24 hrs. after shot

Gas Cu. Ft.

Dry Hole

Abandoned

Date

SEP 5 1946 19

S. J. LEWIS Scout

Form 26 200 Bks. 10-46 Petrol Kansas Hugoton Pool

KANSAS

Map No. Sec. 26 Twp. 31 R. 35W

Well No. 1 Barnes


Derby etal. Company

COMPLETED Contractor

C Sec.

E/, 2980

SECTION PLAT

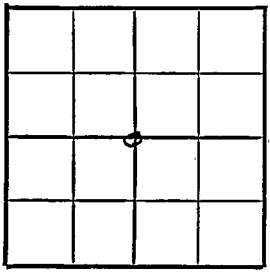

2640 Ft. from N. Line

Ft. from S. Line

2640 Ft. from E. Line

Ft. from W. Line

Stevens County

Location

Rig up

Drilling and Remarks:

7" @ 2576

208 sx 5½" Perf liner @ 2796.

20000 acid

1,316,000 Gas

4½" R Pe

RECORD

Cased in., ft.

Sand

Gas

Oil

Total Depth 2796

PRODUCTION

1st 24 hrs. Nat.

1st 24 hrs. after shot

Gas Cu. Ft.

Dry Hole

Abandoned

Date

JAN 2 1947

19 S. J. LEWIS Scout