

Summer

KANSAS

SECTION 26 TOWNSHIP 31 RANGE 1 W

WELL NO. #5 G. A. Spitler

COMPANY Skelly Oil

NORTH

	0						

WEST

EAST

SOUTH

Summer

KANSAS

SEC.	26	TWP.	31	R.	1W
------	----	------	----	----	----

WELL NO. #5 G. A. Spitler FARM

COMPANY Skelly Oil

CONTRACTOR Hulme Drlg


NE Wellington

_____ Ft. from N. Line

_____ Ft. from S. Line

_____ Ft. from E. Line

_____ Ft. from W. Line

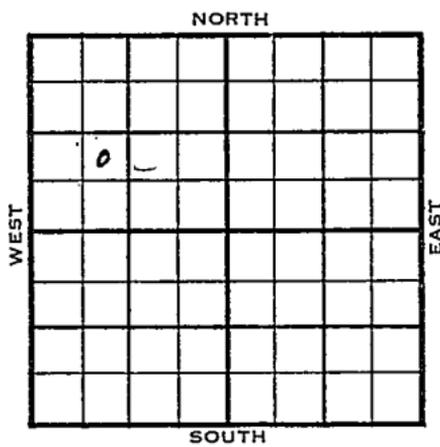

NE SW NW

1955	ELEVATION 1276	REPORT
------	-------------------	--------

11/2 Comm 10-28-55
8^m @ 368/250 WOG

12-7 5¹/₂^m @ 3716
CO to 3682
5⁴/₄ 3662-71, 1000 A,
S/ 72 bo 3 bw, 2⁴/₄ hrs.
S/ 27 bo 46 bw 2⁴/₄ hrs.
Doc-treatment,
CO to 3675 60/ 3662-72
S/ 1¹/₂ boph 2 hrs., 1000 A,
S/ 83 bo, 18 bw 2⁴/₄ hrs.
P/ 57 bo 11 bw 2⁴/₄ hrs.
Comp. 85 bopd 10% wtr.
KC 3002
M. 3652--
Dolo 3660-79
TD 3716

COMPLETED

County Sumner Elev. _____
 Sec. 26 Twp. (31) Rge. IW
 Company Skelly Oil
 Farm Name G. A. Spitler No. 5

TOPS	DEPTH	LOG	DATUM
Anh.			
Tp.			
H.			
Tr.			
Dg.			
Bl.			
L.			
K.C.			
B.K.C.			
Ce.			
C.			
M.			
M.			
K.			
Mz.			
Ma.			
V.			
S.			
S.			
A.			
R.			
Pe.			
G.			
T.D.			

Loc. in Sec. NE SW NW

Geol. _____
 Contr. Hume Drlg.

Pool NE Wellington

0		
NOV 2 '55		

FIRST REPORT

Date Comm. 10-28-55
6" @ 358/250 WOG

~~14~~

Co. No. Use. No. Sec. T. R.

County Sumner Elev. 1276 Co. 11
 Sec. 26 Twp. 31 Rge. 1W
 Company Skelly Oil
 Farm Name G. A. Spitler No. 5

TOPS	DEPTH	LOG	DATUM	Loc. in Sec.
Anh.				NE SW NW
TP.				
H.				
Tr.				
Dg.				
BL.				
L.				
K.C.	<u>3002</u>		<u>1726</u>	Geol.
B.K.C.				Contr.
Ce.				
C.				<u>Hulme Drlg.</u>
M.	<u>3652</u>		<u>2376</u>	
M. <u>Data</u>	<u>3660-79</u>		<u>2384</u>	Pool
K.				<u>NE Wellington</u>
Mz.				
Mq.				
V.				
S.				
S.				
A.				
R.				
PE.				
G.				
TD.	<u>3716</u>			

Date Comm. 10-28-55

DEC 7 1955

8" @ 358/250 5 $\frac{1}{2}$ " @ 3716 CO to 36825 $\frac{1}{2}$ / 3662-71 1000 A S/ 72 bo 3 bw2 $\frac{1}{2}$ hr. S/ 27 bo 46 bw 2 $\frac{1}{2}$ hr.

doc-treatment CO to 3675 60/ 3662-72

S/ 1 $\frac{1}{2}$ boph 2 hr. 1000 A S/ 83 bo18 bw 2 $\frac{1}{2}$ hr. P/ 57 bo 11 bw 2 $\frac{1}{2}$ hr.

Comp. 85 bopd 10% wtr.

COMPLETED