


Stevens

Form 51-5M-2-29-34703

Map No. **KANSAS** Sec. *27* Twp. *31* R. *38^w*

Well No. *1 - French* Farm
Colorado Gas & Utility Company

NORTH

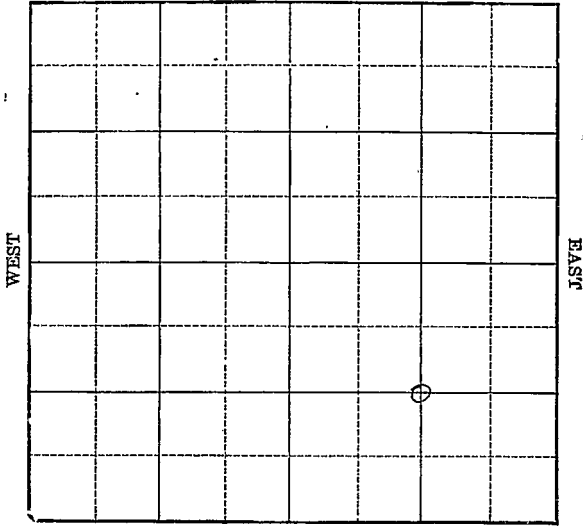

SOUTH

Location _____

Drilling Remarks _____

Rig Up _____

Drilling Remarks _____

RECORD

Cased _____ in. _____ ft.

Sand _____

Gas _____

Oil _____

Total Depth _____

PRODUCTION

1st 24 hrs. Nat. _____

1st 24 hrs. after shot _____

Gas _____ cu. ft. _____

Dry Hole _____

Abandoned _____

Stevens

Map No. KANSAS Sec. 27 Twp. 31 R. 38 ^WWell No. 1 WrenchCaloroso Gas & Utility Company

Contractor

FIRST REPORTS

..... Ft. from N. Line

1320 Ft. from S. Line1320 Ft. from E. Line

..... Ft. from W. Line

SECTION PLAT

Location

Rig up

Drilling and Remarks:

RECORD

Cased..... in., ft.

Sand.....

Gas.....

Oil.....

Total Depth.....

PRODUCTION

1st. 24 hrs. Nat.

1st. 24 hrs. after shot.....

Gas..... Cu. Ft.

Dry Hole.....

Abandoned.....

Date

AUG 1 2 1931

192 CHAS. L. SHERWOOD
Scout

Stevens

Map No. **KANSAS** Sec. *27* Twp. *31* R. *38*^W

Well No. *1 Wrench*

Colours Gas & Utility Company

Contractor

COMPLETED

SECTION PLAT

.....Ft. from N. Line

132.0 Ft. from S. Line

132.0 Ft. from E. Line

.....Ft. from W. Line

Location.....

Rig up.....

Drilling and Remarks:

RECORD

Cased.....in.,ft.

Sand.....

Gas.....

Oil.....

Total Depth *2640*.....

PRODUCTION

1st 24 hrs. Nat.....

1st 24 hrs. after shot.....

Gas *14 M*.....Cu. Ft.

Dry Hole.....

Abandoned.....

Date

SEP 16 1931

CHAS. L. SHERWOOD

Scout