

KANSAS

Seward


Section 27 Township 31 Range 34W

Well No. 1 Federal Farm Mortgage

Company Cities Service'

Hugoton Pool

NORTH

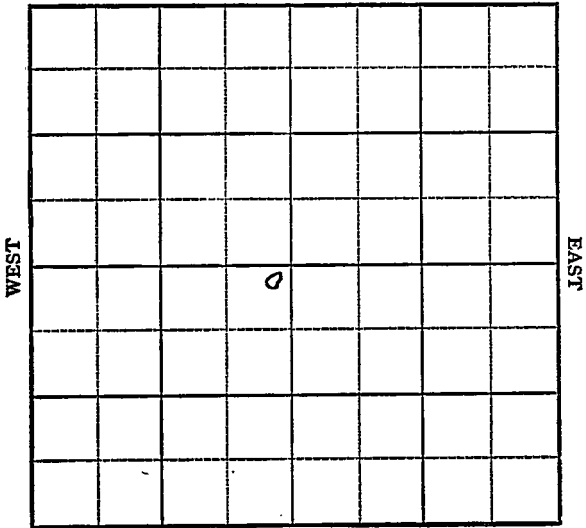

SOUTH

Sec. 27 Twp. 31 R. 34-W

Well No. #1 Federal Farm Mortgage Farm
Cities Service Company
Hugoton


100 Ft. from N. Line

_____ Ft. from S. Line

100 Ft. from E. Line

_____ Ft. from W. Line

NE SW

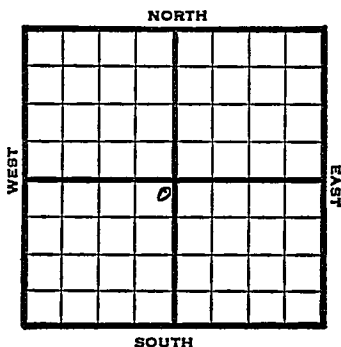

1948 Eli 2789' REPORT

- 10/6 Location
- 10/13 "
- 10/19 8" @ 560'
- 10/26 TD 2602'
5" @ 2601'
- 11/3 120 shots 2546-70
180 shots 2496-2532
120 shots 2440-80 3500acid
- 11/10 Total 28000 acid
- 11/16 "
- 11/23 "
- 11/30 "
- 12/8 TD 2602'
5"@ 2601'
Perf 28000 acid
10,500,000 Gas
418# R Pr.
Comp

COMPLETED

Map No. _____ Sec. 27 Twp. 31 R. 34W

Well No. 1 Federal Farm Mortgage

Cities Service Company

FIRST REPORT

Contractor

NE SW

SECTION PLAT

100 Ft. from N. Line

_____ Ft. from S. Line

100 Ft. from E. Line

_____ Ft. from W. Line

	o		

Seward County

Location X

Rig up _____

Drilling and Remarks:

RECORD

Cased _____ in., _____ ft.

Sand _____

Gas _____

Oil _____

Total Depth _____

PRODUCTION

1st 24 hrs. Nat. _____

1st 24 hrs. after shot _____

Gas _____ Cu. Ft.

Dry Hole _____

Abandoned _____

Date

OCT 6 1948

19

S. J. LEWIS

Scout

Kansas

Map No. _____ Sec. 27 Twp. 31 R. 34WWell No. 1 Federal Farm Mortgage

_____ Cities Service _____ Company

_____ COMPLETE _____ Contractor

NE SW

E 12789
SECTION PLAT100 Ft. from N. Line

_____ Ft. from S. Line

100 Ft. from E. Line

_____ Ft. from W. Line

	o		

Seward County

Location _____

Rig up _____

Drilling and Remarks:

5" @ 260'Perf.28000 aced10,500,000 gal418 R/A

RECORD

Cased _____ in., _____ ft.

Sand _____

Gas _____

Oil _____

Total Depth 2602

PRODUCTION

1st 24 hrs. Nat. _____

1st 24 hrs. after shot _____

Gas _____ Cu. Ft.

Dry Hole _____

Abandoned _____

Date

DEC 8 1948 19

S. J. LEWIS Scout