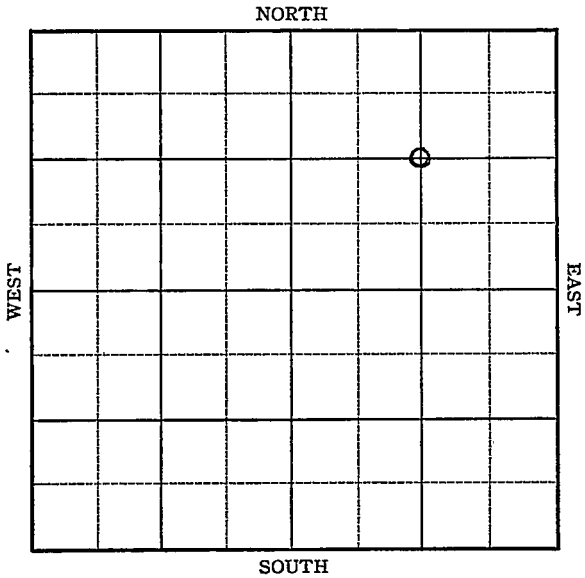


Stevens

KANSAS


Section 27 Township 31 Range 37-WWell No. 1 NewbyCompany Panhandle Eastern

KANSAS

Stevens

Sec. 27 Twp. 31 R. 37-WWell No. #1 Newby FarmPanhandle Eastern Company1320 Ft. from N. Line Ft. from S. Line1320 Ft. from E. Line Ft. from W. Line

Elev. 3099'.

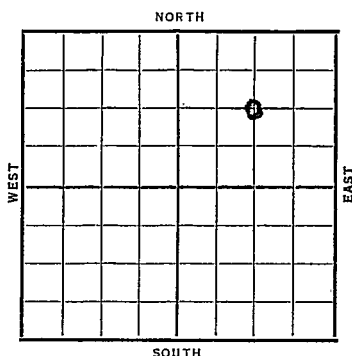

Date

REPORT

1937

12/22

B.R.R.

12/31

"

1938

1/7

Drlg. 530'.

1/14

10" @ 561'. Drlg. 1530'.

1/20

7" - 2481' RUST.

1/28

S.D. @ 2595' 1 M gas.

2/4

T.D. 2850' 1½ M gas.

2/11

P.B. 2650'. 2000 acid.

Testing.

2/16

7" @ 2481'.

Sand 2481'.

T.D. 2850'.

P.B. 2650'.

2000 acid.

5000 acid.

3½ M gas.

COMPLETED

Stevens **KANSAS**Map No. NM Sec. 27 Twp. 31 R. 37WWell No. 1 NewbyPanhandle Eastern Company

Contractor

FIRST REPORT**C NE**1320 Ft. from N. Line Ft. from S. Line1320 Ft. from E. Line Ft. from W. Line**SECTION PLAT**

Location Rig up

Drilling and Remarks:

BRR**RECORD**Cased in., ft.Sand Gas Oil Total Depth **PRODUCTION**1st 24 hrs. Nat. 1st 24 hrs. after shot Gas Cu. Ft.Dry Hole Abandoned

Date

DEC 22 1937

19

H. D. Hatfield

Scout

Stevens KANSAS

Map No. N 14 Sec. 27 Twp. 31 R. 37WWell No. 1 NewbyPanhandle Eastern

Company


Contractor

COMPLETED**C/NE**1320 Ft. from N. Line

Ft. from S. Line

1320 Ft. from E. Line

Ft. from W. Line

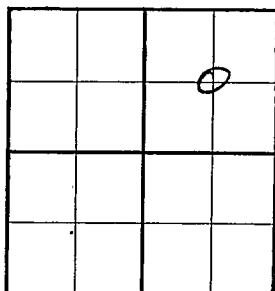SECTION PLAT

Location

Rig up

Drilling and Remarks:

P.B. 2650
 2000 Acid
 5000 A -
 3 1/2 M. gas

RECORDCased 7 in., 2481 ft.Sand 2481

Gas

Oil

Total Depth 2850**PRODUCTION**

1st 24 hrs. Nat.

1st 24 hrs. after shot

Gas Cu. Ft.

Dry Hole

Abandoned

Date

FEB 16 1938

19

H. D. Hatfield

Scout