


Section 27 Township 31 Range 35WWell No. #1 AndersonCompany Northern Natural Gas

NORTH

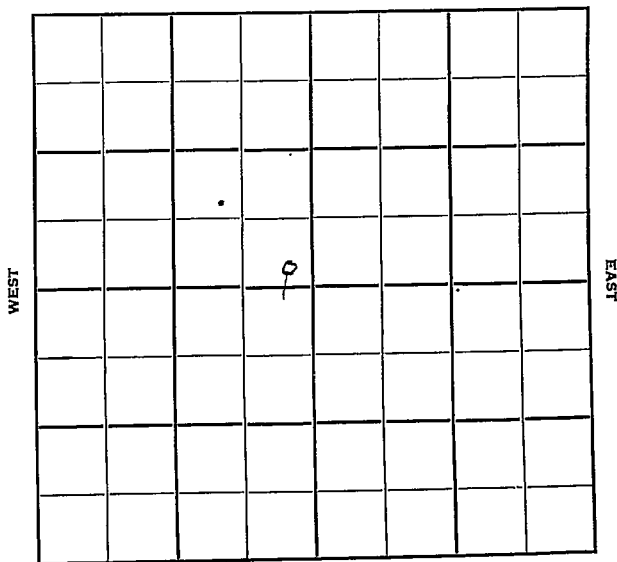

SOUTH

Sec. 27 Twp. 31 R. 35W ✓

Well No. #1 Anderson Farm

Northern Natural Gas Company

Hugoton Pool Contractor

Ft. from N. Line

200'


Ft. from S. Line

200'

Ft. from E. Line

Ft. from W. Line

SE NW

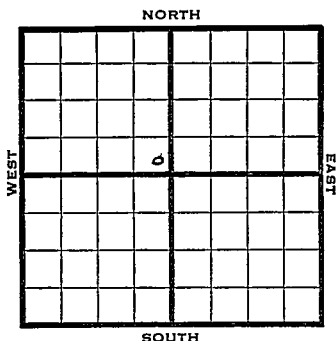

1950

Elev 2998' REPORT

4/19

Spud 4-12-50

10" @ 520'

TD 2560'

7" @ 2552'

WOC

5/3

TD 2826'

10"@ 520'

7"@ 2552'

Her 2575'

Kr 2637'

Win 2882'

24,687,000 CFCPD

Comp

COMPLETED

Map No. _____ Sec. 27 Twp. 31 R. 35WWell No. 1 Anderson

_____ Northern Natural Gas _____ Company

_____ Contractor


SE NW

SECTION PLAT

_____ Ft. from N. Line

200 Ft. from S. Line200 Ft. from E. Line

_____ Ft. from W. Line

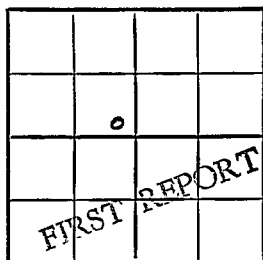

Stevens County

Location _____

Rig up _____

Drilling and Remarks:

Spud 4-12-50

10" @ 520

TD 2560

7" @ 2552

WOC

RECORD

Cased _____ in., _____ ft.

Sand _____

Gas _____

Oil _____

Total Depth _____

PRODUCTION

1st 24 hrs. Nat. _____

1st 24 hrs. after shot _____

Gas _____ Cu. Ft.

Dry Hole _____

Abandoned _____

Date

J. E. TYRA

APR 19 1950 19 _____ Scout

Kansas

Hugoton Pool

Map No. _____ Sec. 27 Twp. 31 R. 35^WWell No. 1 Anderson_____
Northern Natural Gas Company_____
Contractor

SE NW

E1. 2998
SECTION PLAT_____
Ft. from N. Line200 Ft. from S. Line200 Ft. from E. Line_____
Ft. from W. Line

		COMPLETE	
	0		

Stevens County

Location _____

Rig up _____

Drilling and Remarks:

10" @ 520
7" @ 2552
Rv 2575
Rv. 2637
Win 2882

24,687,000

Date

CFGPD

MAY 3 1950

19

RECORD

Cased _____ in., _____ ft.

Sand _____

Gas _____

Oil _____

Total Depth 2826

PRODUCTION

1st 24 hrs. Nat. _____

1st 24 hrs. after shot _____

Gas _____ Cu. Ft.

Dry Hole _____

Abandoned _____

J. E. TYRA

Scout