


Section 27 Township 31 Range 33 W

Well No. # 1 Miller Gas Unit "F"

Company Stanolind

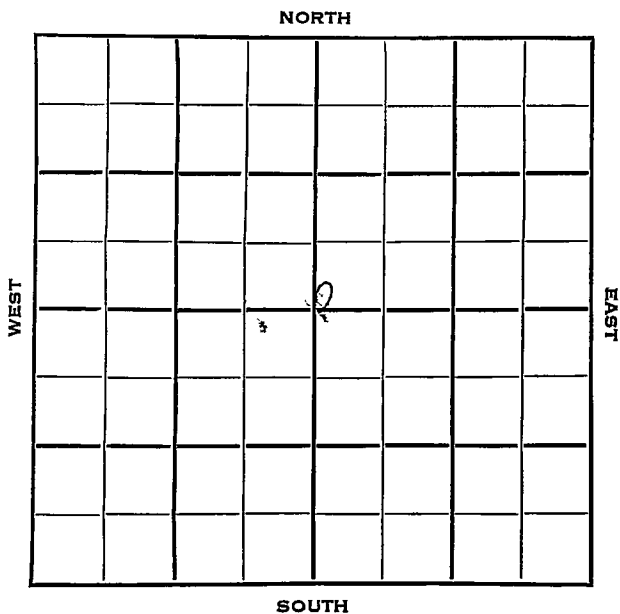

Seward KANSAS

SEC. 27	TWP. 31	R. 33W ✓
------------	------------	-------------

WELL NO. 1 Miller Gas Unit "F" FARM

COMPANY Stanolind

CONTRACTOR


Hugoton Pool

_____ Ft. from N. Line

150 _____ Ft. from S. Line

_____ Ft. from E. Line

150 _____ Ft. from W. Line

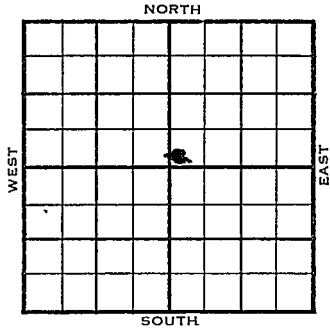

SW SW NE

1954	ELEVATION	REPORT
------	-----------	--------

4/21
6/9

Location
Spudding 4-19-54
Gas well
TD 2723
8" @ 603
Her 2660 Kri.2673 Win 2710
TD 2723
5" : 2710 CO 2723 2500 A
4,176,000 gas 48/2640-48
18/2652-55 18// 2666-69
54/2673-82 60/2684-94 4000A
4,375,000 gas 9000A 8,632,000 gas
6000A 3000A comp.19 mcf/gpd
390#

COMPLETED

