


Sumner **KANSAS**

SECTION 27 TOWNSHIP 31 RANGE 1 W

WELL NO. # 1 Voils

COMPANY Petroleum Inc.

NORTH

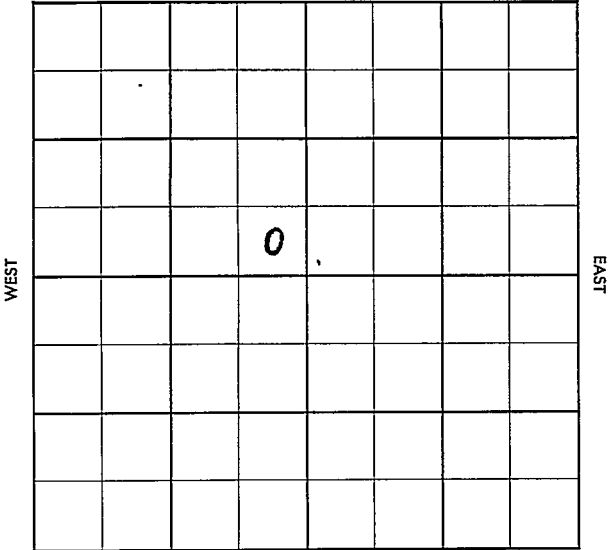

SOUTH


SEC. 27	TWP. 31	R. 1W
------------	------------	----------

WELL NO. #1 Voils FARM

COMPANY Petroleum Inc.

CONTRACTOR Garvey

NE Wellington  
 \_\_\_\_\_ Ft. from N. Line  
 \_\_\_\_\_ Ft. from S. Line  
 \_\_\_\_\_ Ft. from E. Line  
 \_\_\_\_\_ Ft. from W. Line

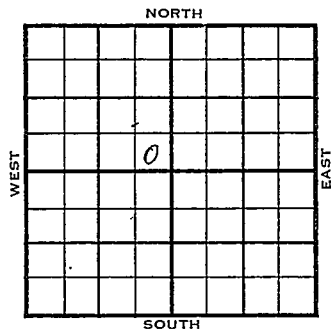

SE SE NW

Magnolia - FO

	ELEVATION	REPORT
1956	1263'	

4-25 Comm. 4-23-56  
8" @ 315 w/275

5-9 # DST 2662-87 op 1 hr. rec. 16 20' SW  
100/20"  
D & A  
Tp. 1939', H. 2333', Dg. 2406',  
BL. 2649', Stall 2659', KC 3017',  
BKC 3251', Chhd. 3290', Cleve 3307'.  
Altom 3280', Ft. Scto. 3437', Ce. 3486',  
Miss. 3657'.  
TD 3757'.

**ABANDONED**

County Sumner Elev. \_\_\_\_\_  
 Sec. 27 Twp. 31 Rgs. IW  
 Company Petroleum Inc.  
 Farm Name Voils No. 1

TOPS	DEPTH	LOG	DATUM
Anh.			
TP.			
H.			
Tr.			
Dg.			
Bl.			
L.			
K.C.			
B.K.C.			
Ce.			
C.			
M.			
M.			
K.			
Mz.			
Mo.			
V.			
S.			
S.			
A.			
R.			
PE.			
G.			
T.B.			

Loc. in Sec. SE SE NW  
 Geol. \_\_\_\_\_  
 Contr. Garvey  
 Pool NE Wellington

FIRST REPORT  
 0  
 APR 25 56

Date Comm. 4-23-56 Magnolia FO  
8" @ 315/275

WY 5 18PP

*Handwritten scribbles and numbers*

Co.  
 Lse.  
 No.  
 Sec.  
 T.  
 R.

County Sumner Elev. 1203  
 Sec. 27 Twp. 31 Rge. 1W  
 Company Petroleum Inc.  
 Farm Name Voils No. 1

TOPS	DEPTH	LOG	DATUM	Loc. in Sec.
Anh.				SE SE NW
Tp.	1939			
H.	2339			
Tr.				
Dg.	2406			
Bl.	2649			
L. <u>stall</u>	2659			Geol.
K.C.	3017			Contr.
B.K.C.	3251			<u>Garvey</u>
Co. <u>chhd</u>	3290			Pool
Gr. <u>clay</u>	3307			<u>NE Wellington</u>
M. <u>Flitorn</u>	3380			<div style="border: 1px solid black; padding: 5px; text-align: center;"> <p><b>ABANDONED</b></p> <p>0</p> <p>MAY 9 1956</p> </div>
M. <u>Et sct 3</u>	3437			
K. <u>ce</u>	3486			
Mz. <u>MISS</u>	3657			
Me.				
V.				
S.				
S.				
A.				
R.				
PE.				
G.				
TD.	3757			

Date Comm. 4-23-56 Magnolia FO  
 8" @ 315/275 MAY 2 '56 @ 2646 @ 3050  
 8" @ '56 DST 2662-87 1hr run 1620'  
 SW 1000/20

*D & A.*

Co.  
No.  
Sec.  
T.  
R.