28-31-28 SW

TYPE

AFFIDAVIT OF COMPLETION FORM

ACO-1 WELL HISTORY

State Geological Survey
WICHITA BRANCH

Compt.____ PI

SIDE ONE

Two (2) copies of this form shall be filed with the Kansas Corporation Commission, 200 Colorado Derby Building, Wichita, Kansas 67202, within thirty (30) days after the completion of a well, regardless of how the well was completed.

Attach separate letter of request if the information is to be held confidential. If confidential, only file one copy. Information on Side One will be of public record and Side Two will then be held confidential.

Applications must be made on dual completion, commingling, salt water disposal, injection and temporarily abandoned wells.

XX Attach one copy only wireline logs (i.e. electrical log, sonic log, gamma ray neutron log, etc.). (Rules 82-2-105 & 82-2-125) KCC# (316) 263-3238.

LICENSE # 5760 EXPIRATION DATE 6-30-83

OPERATOR IREX Corporation API NO. 15-119-20,604

ADDRESS 1670 Broadway - Suite 3301 COUNTY Meade

Denver, Colorado 80202 FIELD Wildcat

** CONTACT PERSON Linda Drennen/Well Records Supervisor PROD. FORMATION N/A

PHONE (303)571-5736

PURCHASER N/A LEASE Fisher

ADDRESS ____ WELL NO. #1

WELL LOCATION SW NE

DRILLING CONTRACTOR Rains & Williamson Oil Co., Inc. 660 Ft. from South Line and

ADDRESS 435 Page Court, 220 W. Douglas 1980 Ft. from East Line of


Wichita, Kansas 67202 the ____ (Qtr.) SEC 28 TWP 31S RGE 28 (W).

PLUGGING CONTRACTOR ~~Same~~ Halliburton Cementing

ADDRESS 1100 E. 8th

Hays, Kansas 67601

WELL PLAT

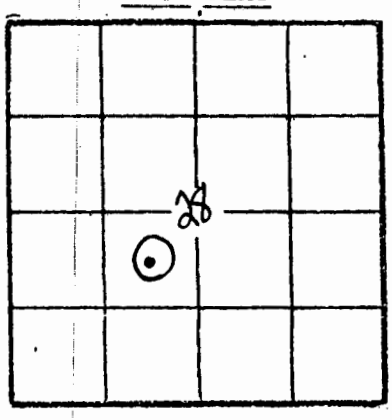

(Office Use Only)
KCC ____
KGS ✓
SWD/REP ____
PLG. ____

TOTAL DEPTH 5800' PBTD ____

SPUD DATE 4-15-83 DATE COMPLETED 4-29-83

ELEV: GR 2610' DF 2619' KB 2620'

DRILLED WITH (CABLE) (ROTARY) (AIR) TOOLS.

DOCKET NO. OF DISPOSAL OR REPRESSURING WELL BEING USED TO DISPOSE OF WATER FROM THIS LEASE ____.

Amount of surface pipe set and cemented 1518' DV Tool Used? ____.

THIS AFFIDAVIT APPLIES TO: (Circle ONE) - Oil, Gas, Shut-in Gas, (Dry) Disposal, Injection, Temporarily Abandoned, OWWO. Other ____.

ALL REQUIREMENTS OF THE STATUTES, RULES AND REGULATIONS PROMULGATED TO REGULATE THE OIL AND GAS INDUSTRY HAVE BEEN FULLY COMPLIED WITH. Yes

A F F I D A V I T

I, William H. Bayliff, Operations Manager, being of lawful age, hereby certifies that:

I am the Affiant, and I am familiar with the contents of the foregoing Affidavit. The statements and allegations contained therein are true and correct.

William H. Bayliff
(Name)

SIDE TWO

ACO-1 WELL HISTORY XXX

OPERATOR IREX Corporation LEASE Fisher #1 SEC. 28 TWP. 31S RGE. 28 (W)

FILL IN WELL INFORMATION AS REQUIRED: WELL NO. _____

Show all important zones of porosity and contents thereof; cored intervals, and all drill-stem tests, including depth interval tested, cushion used, time tool open, flowing and shut-in pressures, and recoveries.

SHOW GEOLOGICAL MARKERS, LOGS RUN, OR OTHER DESCRIPTIVE INFORMATION.

FORMATION DESCRIPTION, CONTENTS, ETC.	TOP	BOTTOM	NAME	DEPTH
____ Check if no Drill Stem Tests Run.				
Heebner Sh. (-1734)	4354			
Toronto (-1749)	4369			
Lansing (-1871)	4491			
Base K. C. (-2324)	4944			
Marmaton (-2437)	4957			
Ft. Scott Ls. (-2559)	5179			
Cherokee Sh. (-2577)	5197			
Chester (-2791)	5411			
St. Genevieve (-2940)	5560			
St. Louis (-3048)	5668			
DST #1, 5135-5162, Marmaton. Open 30-30-30-60 min. IHP 2646 FHP 2646 IFP 33 FFP 92 ISIP 1670 FSIP 1670 REc. 180' DM. IF-FF had strong blow.				
DST #2, 5386-5446, Chester. Open 30-60-45-90 min. IHP 2711 FHP 2662 IFP 82 FFP 82 ISIP 1392 FSIP 1245 Rec. 270' GCM. IF had strong blow. FF had GTS in w min. on 2nd opening.				
Cyberlook	4000	5775		
CNL w/ GR	4000	5775		
DIL-SFL w/ GR	1520	5790		
If additional space is needed use Page 2, Side 2			T.D.	5790

State Geological Survey
WICHITA BRANCH

Report of all strings set — surface, intermediate, production, etc. CASING RECORD (New) or (Used)

Purpose of string	Size hole drilled	Size casing set (in O.D.)	Weight lbs/ft.	Setting depth	Type cement	Sacks	Type and percent additives
Surface	12¼"	8 5/8"	24#	1518'	Class H Lite	200 sx. 600 sx.	3% cc. 2% cc.

LINER RECORD

Top, ft.	Bottom, ft.	Sacks cement

TUBING RECORD

Size	Setting depth	Packer set at

PERFORATION RECORD

Shots per ft.	Size & type	Depth interval