


Harpur

Map No. *Kans.* Sec. *28* Twp. *31* R. *9W.*
 Well No. *1 Muir* Farm
Mackfield Etal. Company

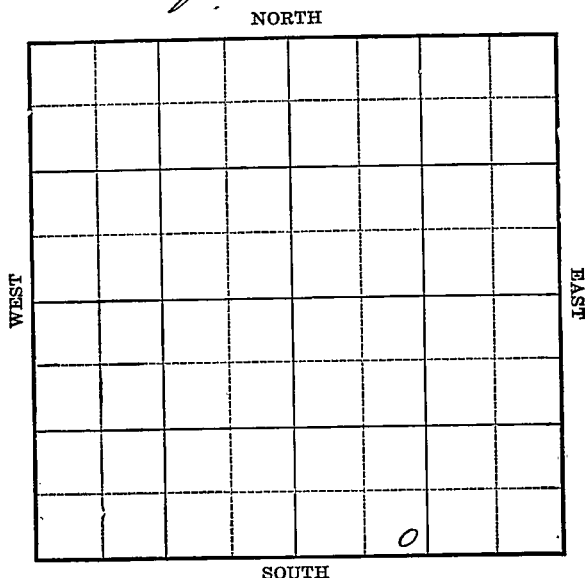

Location.....
 Drilling Remarks

Rig Up.....
 Drilling Remarks

RECORD

Cased.....in.ft.
 Sand ..
 Gas ..
 Oil ..
 Total Depth.....

PRODUCTION


1st 24 hrs. Nat.....
 1st 24 hrs. after shot.....
 Gas.....cu. ft.
 Dry Hole ..
 Abandoned ..

Map No. Kansas Sec. 28 Twp. 31 R. 9^wWell No. 1 Muir FarmWakefield et al Company

_____ Ft. from N. Line

300 Ft. from S. Line

_____ Ft. from E. Line

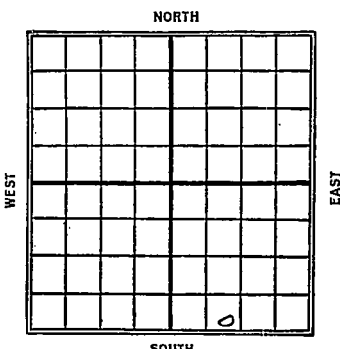990 Ft. from W. Line

Date	REPORT
4/14	Location
4/21	—
4/29	—
5/5	Spud
5/12	Drilling 1105'
5/19	" 1490
5/26	" 2020
6/2	" 2270
6/9	T.D. 2270 S.D.
6/16	same
6/23	—
6/30	T.D. 2270 U.P. 10"
7/14	Drilg 2330
7/22	" 2545
7/28	" 3050 - H.F.W.
8/4	" 3250
8/11	T.D. 3250 repairing
8/18	Drilg 3360 - H.F.W.
8/25	T.D. 3400 - U.P. 8"
9/1	—
9/8	Drilg 3440
9/15	show gas 3590-3610 Drilg 3700 - H.F.W.

Drlg - 3 790

9/29 - 5" at 3866 - J.S.

show oil, shut down
for orders

10/6 - no report high water

10/13 - Drlg 3975

10/20 - " 4035

10/27 - Drlg 4207 - S.L.M.

11/3 - J.D. 4225 - S.D.

11/10 - same

11/17 - Drlg 4240

11/24 - Same

12/1 - Drlg 4260

12/8 - T.D. 4260' S.D.

12/15 - Run 5" C. 4275'

12/21 - top chat 4430 gas drlg
4460 in chat H.F.W.

1/29 - Abandoned 4470

Map No. **KANSAS** Sec. 28 Twp. 31 R. 2W

Well No. 1 Muir

Wapfield & Co Company

Contractor

SECTION PLAT

-----Ft. from N. Line

300 Ft. from S. Line

-----Ft. from E. Line

790 Ft. from W. Line

FIRST REPORTS

Location -----

Rig up -----

Drilling and Remarks:

Location

RECORD

Cased ----- in., ----- ft.

Sand -----

Gas -----

Oil -----

Total Depth -----

PRODUCTION

1st 24 hrs. Nat. -----

1st 24 hrs. after shot -----

Gas ----- Cu. Ft.

Dry Hole -----

Abandoned -----

Date

APR 14 1926

S. J. LEWIS

Scout

Returned

Cards

Tracing

France Map

Scarborough Map

Moody Map

Scarborough Plat Book

Moody Plat Book

MAP No. _____ SEC. 28 TWP. 31S R. 9WWELL No. 1 WmWakefield

COMPANY _____

CONTRACTOR _____

SECTION PLAT

_____ FT. FROM N. LINE

_____ FT. FROM S. LINE

_____ FT. FROM E. LINE

_____ FT. FROM W. LINE

RECORD

LOCATION _____

CASED _____ IN. _____ FT.

RIG UP _____

SAND _____

DRILLING AND REMARKS:

GAS _____

OIL _____

TOTAL DEPTH 2140

PRODUCTION

1ST 24 HRS. NAT. _____

1ST 24 HRS. AFTER SHOT _____

GAS _____ CU. FT.

DRY HOLE ☒ABANDONED ☒

DATE

1/12 1927

SCOUT _____

Map No. **KANSAS** Sec. *28* Twp. *31* R. *9W*

Well No. *1 Muir*

Wakfield & Co. Company

Contractor

SECTION PLAT

Ft. from N. Line

300 Ft. from S. Line

Ft. from E. Line

990 Ft. from W. Line

ABANDONED

Location

Rig up

Drilling and Remarks:

T.D. 4470

J & A.

RECORD

Cased _____ in., _____ ft.

Sand _____

Gas _____

Oil _____

Total Depth _____

PRODUCTION

1st 24 hrs. Nat. _____

1st 24 hrs. after shot _____

Gas _____ Cu. Ft.

Dry Hole _____

Abandoned _____

Date

DEC 29 1926

S. J. LEWIS

Scout

Returned	
Cards	<i>None</i>
Tracing	<i>None</i>
France Map	
Scarborough Map	<i>X</i>
Moody Map	
Scarborough Plat Book	
Moody Plat Book	

No Small map

No Wall map