


KANSAS StevensSection 28 Township 31 Range 36WWell No. 1 ThurowCompany Texas et alHugoton
NORTH

SOUTH

KANSAS

Stevens

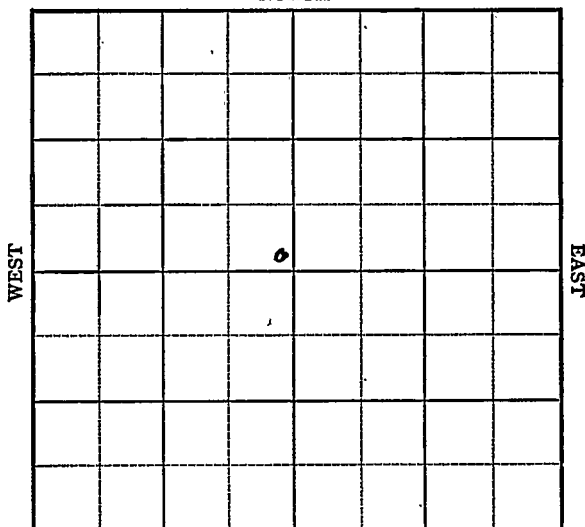

Sec. 28 Twp. 31 R. 36W

Well No. #1 Thurow Farm

Texas et al Company

Hugoton Pool


Ft. from N. Line

165' Ft. from S. Line

165' Ft. from E. Line

Ft. from W. Line

SE NW

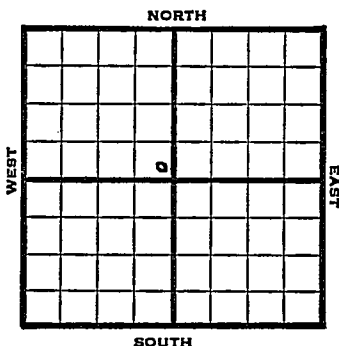

1949 Elev 3071' REPORT

3/9 RUR

3/16 "

3/23 10" @ 652'
Drlg 1781'

3/30 Drlg. 2703'

4/6 TD 2861'
7" @ 2860'

4/12 "

4/20 84 shots 2874-28 - 1000 acid

4/27 282 shots 2755-2802
165 " 2704-32
180 " 2658-88
136 " 2634-40 - 19,000 acid

5/4 "

5/10 "

5/18 TD 2861'
7" @ 2860'
Perf 20000 acid
18,914,000 Gas
428# R Pr.
Comp**COMPLETED**

Map No. _____ Sec. 28 Twp. 31 R. 36W

Well No. 1 Thurow

Texas et al.


Company

FIRST REPORT

Contractor

SE NW

SECTION PLAT

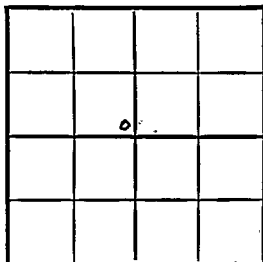

_____ Ft. from N. Line

165 Ft. from S. Line

165 Ft. from E. Line

_____ Ft. from W. Line

Stevens County

RECORD

Location _____

Cased _____ in., _____ ft.

Rig up _____

Sand _____

Drilling and Remarks:

Gas _____

R U R

Oil _____

Total Depth _____

PRODUCTION

1st 24 hrs. Nat. _____

1st 24 hrs. after shot _____

Gas _____ Cu. Ft.

Dry Hole _____

Abandoned _____

Date

MAR 9 1949

19

S. J. LEWIS

Scout

Map No. _____ Sec. 28 Twp. 31 R. 36W

Well No. 1 Thurrow

_____ Texas et al. _____ Company

COMPLETE

_____ Contractor

SE NW

E 13071
SECTION PLAT

_____ Ft. from N. Line

165 Ft. from S. Line

165 Ft. from E. Line .

_____ Ft. from W. Line

	0		

Stevens County

Location _____

Rig up _____

Drilling and Remarks:

7" 62860
Prof.
20000 and
15,914,000 lbs
425 R

RECORD

Cased _____ in., _____ ft.

Sand _____

Gas _____

Oil _____

Total Depth 2561

PRODUCTION

1st 24 hrs. Nat. _____

1st 24 hrs. after shot _____

Gas _____ Cu. Ft.

Dry Hole _____

Abandoned _____

Date

MAY 18 1949 19

S. J. LEWIS Scout