


Section 28 Township 31 Range 33W

Well No. #1 Good Gas Unit

Company Stanolind

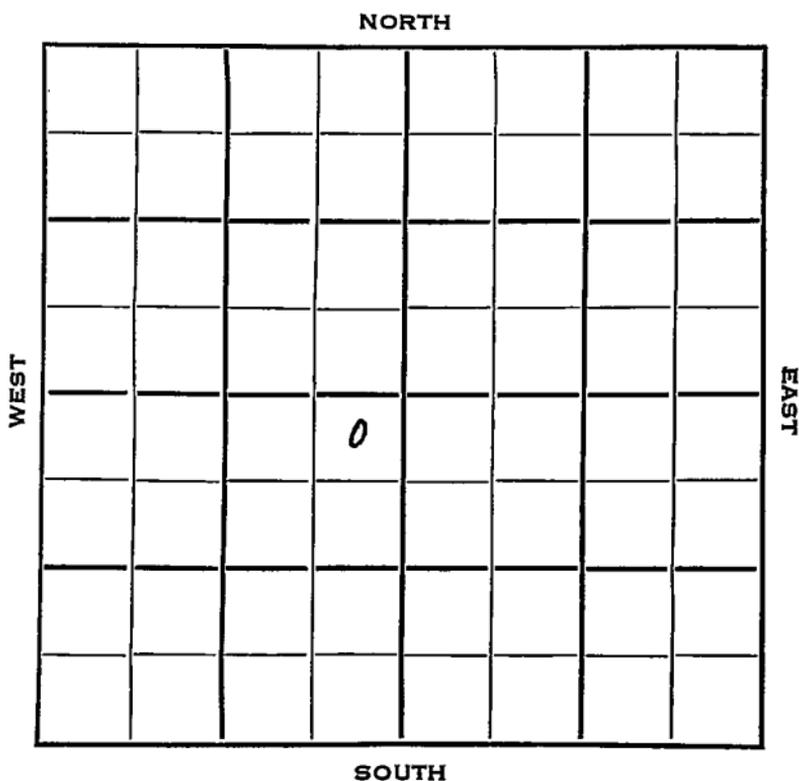

Seward KANSAS

SEC. 28	TWP. 31	R. 33W ✓
------------	------------	-------------

WELL NO. 1 Good Gas Unit FARM

COMPANY Stanolind

CONTRACTOR


Hugoton Pool

150 Ft. from N. Line

Ft. from S. Line

150 Ft. from E. Line

Ft. from W. Line

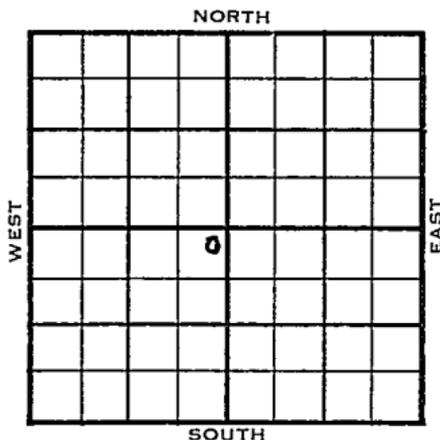

NE NE SW

1954	ELEVATION	REPORT
	2888'	

3/24 8" @ 606'
Drig. 1225'

3/31 RTD 2725'
Her. 2624', Kr. 2660', Win 2708'
5" @ 2708'

4/7 WOCT.

4/21 Gas Well
TD 2725'
8" @ 606'
Her. 2624', Kri 2660', Win 2708'
TD 2725'
5" @ 2708'
CO to 2725'
2500 A 3,070,000 cfg 24/ 2632-36
18/ 2639-42 12/ 2651-53 12/ 2662-64
36/ 2666-72 42/ 2677-84 250000
3,339,000 cfg 7000 A 4000 A
3,898,000 cfg. 2000 A
Comp 6,598,000 gas 405#

COMPLETED

