


Section ~~21~~ 28 Township 31 Range 32 WWell No. # 1 Shapland PRINTZCompany ~~Burris Drilg Co.~~ Ohio

NORTH

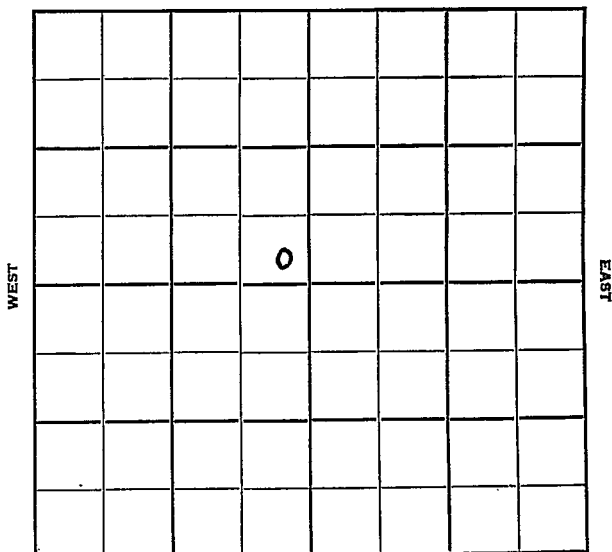

SOUTH

Seward

Sec. ~~21~~ 28 Twp. 31 R. 32W

Well No. #1 ~~Shapland~~ ^{PRINT 2} Farm

~~Burris Drlg. Co.~~ ^{Ohio} Company

Burris Drlg. - Contr. Contractor

Ft. from N. Line

~~330~~ 200


Ft. from S. Line

~~330~~ 200

Ft. from E. Line

Ft. from W. Line

SE SE NW

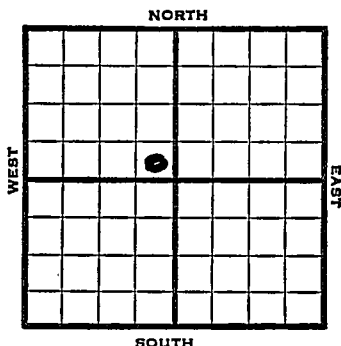

1952

Elev. 2853' REPORT

3/12

Spud 3-11-52

3/19

8" @ 600

Drlg. 2670'

3/25

RTD 2758' 5" @ 2751'

30/2705-10 1500 A

Har 2620' Up Krider 2650'

Low Krider 2674' Winfield 2720'

4/1

72/2686-98 108/2650-68 9500 A

4/9

2000 A 1500 A 4500 A

Ran tbg.

4/16

Spud 3-11-52

Gas Well TD 2758

8" @ 600'

5" @ 2751 TD 2758


30/3105-10 1500 A

Her. 2620 Kri 2650 Win 2720

72/2686-98 108/2650-68 16,000 A

Comp. 4,828,000 gas

COMPLETED

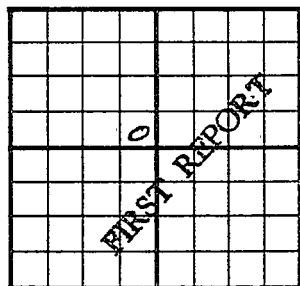County Seward State KansasSec. 21 (Blk. Twp.) 31 (Sur. Rge.) 32W Map No.Operator Burris Drlg. Co.Well No. 1 Farm ShaplandElev. _____ Location SE SE NW200 Ft. From S Line NW200 Ft. From E Line Quarter1st. Report MAR 1 2 1952

Completion _____

Remarks _____

Spudding Date 3-11-52

Drlg. Data _____

J. G. McGEHEE

Map No. _____ Sec. 21 Twp. 31 R. 32W

Well No. 1 Shapland

Ohio Company _____

Contractor _____

SE SE NW

SECTION PLAT

_____ Ft. from N. Line

330 Ft. from S. Line

330 Ft. from E. Line

_____ Ft. from W. Line

CORRECTION			

Seward County

Location _____

Rig up _____

Drilling and Remarks:

Reported

Burris Drlg. Co.

RECORD

Cased _____ in., _____ ft.

Sand _____

Gas _____

Oil _____

Total Depth _____

PRODUCTION

1st 24 hrs. Nat. _____

1st 24 hrs. after shot _____

Gas _____ Cu. Ft.

Dry Hole _____

Abandoned _____

Date

Map No. _____ Sec. 28 Twp. 31 R. 32WWell No. 1 PrintzOhio

Company _____

CORRECTION

Contractor _____

SE SE NW

SECTION PLAT

_____ Ft. from N. Line

200 Ft. from S. Line200 Ft. from E. Line

_____ Ft. from W. Line

Seward County

Location _____

Rig up _____

Drilling and Remarks:

Reported
Burris Drlg.
#1 Shapland
21-31-32W

RECORD

Cased _____ in., _____ ft.

Sand _____

Gas _____

Oil _____

Total Depth _____

PRODUCTION

1st 24 hrs. Nat. _____

1st 24 hrs. after shot _____

Gas _____ Cu. Ft.

Dry Hole _____

Abandoned _____

Date

MAR 26 195219J. G. McGEHEEScout

