


KANSAS
Range 1-W

Well Number...1...Gift

Company.....Stelbar

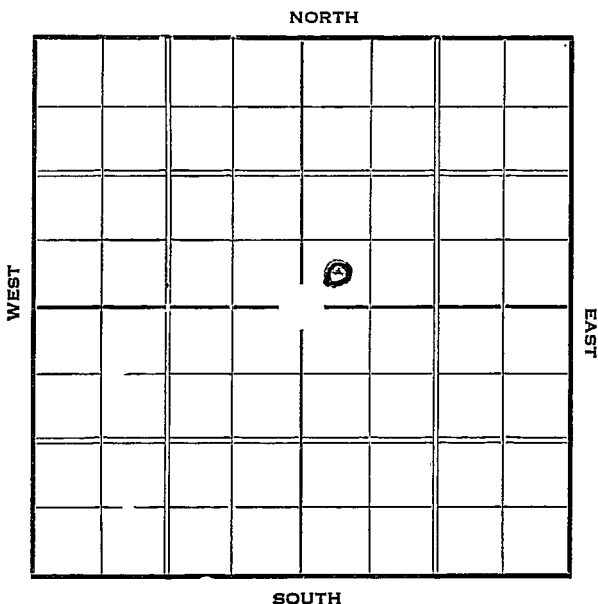

KANSAS

Sumner

Map No. _____ Sec. 28 Twp. 31 R. 1-W

Well No. #1 Giff _____ Farm

_____ Stelbar _____ Company


_____ Ft. from N. Line

330 Ft. from S. Line

_____ Ft. from E. Line

330 Ft. from W. Line

Elev. 1264

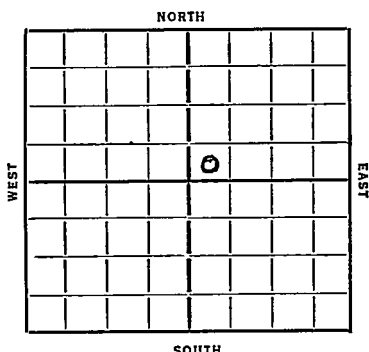Date
1936

REPORT

12/16 Location

12/24 " 12/29--

1937

1/7 Surface hole.

1/14 12" @ 336'. Drlg. 2520'.

1/21 Chat 3668'. T. D. 3671'

Run 7".

1/28 WOC.

2/4 Drlg. 3698'.

2/11 Drlg. 3815'.

2/18 SD 4016'.

2/26 " "

3/4 " "

3/11 Drlg. 4057'

3/18 Drlg. 4095'

3/25 SD 4095'.

3/31 Chat 3668'.

T.D. 4133'.

Simpson 4080'. H.F.W.

ABANDONED

Map No. 31 Sec. 28 Twp. 31 R. 14

Well No. 1 Gift

Stellar Company

Contractor

SECTION PLAT

 Ft. from N. Line

330 Ft. from S. Line

 Ft. from E. Line

330 Ft. from W. Line

FIRST REPORT

Location ✓

Rig up

Drilling and Remarks:

RECORD

Cased in., ft.

Sand

Gas

Oil

Total Depth

PRODUCTION

1st 24 hrs. Nat.

1st 24 hrs. after shot

Gas Cu. Ft.

Dry Hole

Abandoned

Date

DEC 16 1936 19

S. J. LEWIS Scout

KANSAS *Summer*Map No. *31* Sec. *28* Twp. *81* R. *1W*Well No. *1 Gift**Stellar* Company

Contractor

SECTION PLAT

		o	

_____ Ft. from N. Line

330 Ft. from S. Line

_____ Ft. from E. Line

330 Ft. from W. Line

ABANDONED

Location _____

Rig up _____

Drilling and Remarks:

*Oka 83668**HFW**Simpson 4080*

RECORD

Cased _____ in., _____ ft.

Sand _____

Gas _____

Oil _____

Total Depth *4133*

PRODUCTION

1st 24 hrs. Nat. _____

1st 24 hrs. after shot _____

Gas _____ Cu. Ft.

Dry Hole ☒Abandoned ☒

Date

MAR 31 1937

19

S. J. LEWIS Scout