


Map No. WASAS Sec. 28 Twp. 31 R. Summer
 Well No. E. B. Shawver Farm _____ Company _____

NORTH

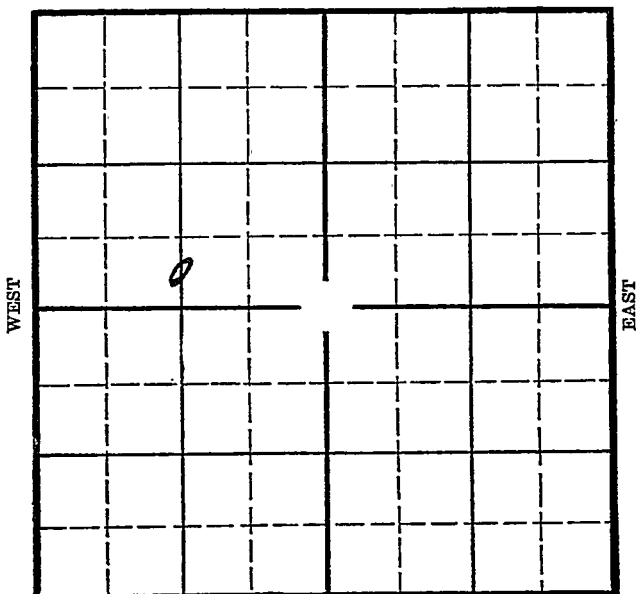

SOUTH

Location _____
 Drilling Remarks _____

RECORD

Cased _____ in. _____ ft.
 Sand _____
 Gas _____
 Oil _____
 Total Depth _____


Rig Up _____
 Drilling Remarks _____

PRODUCTION

1st 24 hrs. Nat. _____
 1st 24 hrs. after shot _____
 Gas _____ cu. ft. _____
 Dry Hole _____
 Abandoned _____

Map No. KANSAS Sec. 28 Twp. 31 R. 1W
Well No. 1- Curtis Farm
E. B. Sharrow Company

 Ft. from N. Line
330 Ft. from S. Line
 Ft. from E. Line
1320 Ft. from W. Line

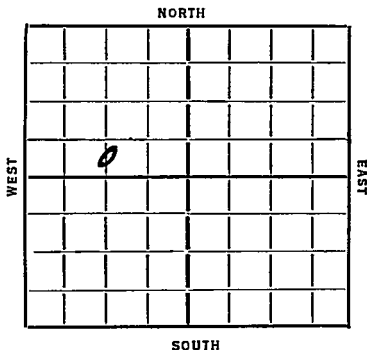

Date	REPORT
1935	
10/27	Location
11/11	Run
11/17	10" 334 WOC
11/14	Dly 1900
11/21	" 3080
11/29	Top 160 3441
	Chat 3659-61 At 7"
12/6	TD 3708 Will Acidize
12/13	1000 acid & again w/ 2000
	acid w.o.A.
12/18	Chat 3659
	TD 3708
	2000 acid
	150 bbls.

COMPLETED

Map No. 31 Sec. 28 Twp. 31 R. 1W


Well No. 1- Curtis

E. B. Shawver Company

Contractor

FEED PORTS

SECTION PLAT

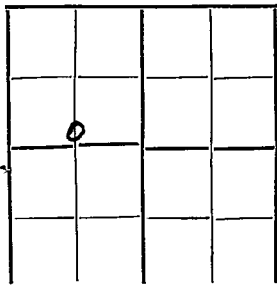

Ft. from N. Line

330 Ft. from S. Line

Ft. from E. Line

1320 Ft. from W. Line

Location ✓

Rig up

Drilling and Remarks:

RECORD

Cased in., ft.

Sand

Gas

Oil

Total Depth

PRODUCTION

1st 24 hrs. Nat.

1st 24 hrs. after shot

Gas Cu. Ft.

Dry Hole

Abandoned

Date

ORVAL MANNSCHPECK

10-24-35 192

Scout

Map No. 31 Sec. 28 Twp. 31 R/W

Well No. 1-Curtis

E. B. Shawner Company

Contractor

COMPLETE


SECTION PLAT

Ft. from N. Line

330 Ft. from S. Line

Ft. from E. Line

1320 Ft. from W. Line

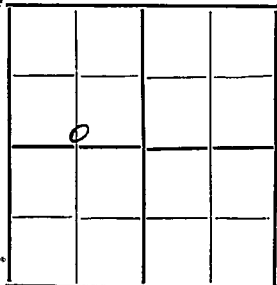

Location

Rig up

Drilling and Remarks:

2000 acid

150 bbls

RECORD

Cased 36 in. 59 ft.

Sand Chat

Gas

Oil

Total Depth 3708

PRODUCTION

1st 24 hrs. Nat.

1st 24 hrs. after shot

Gas Cu. Ft.

Dry Hole

Abandoned

Date

12-18-35 192 ORVAL MANUSSE Scout