

Company

TSTMA

EAST

SOUTH

PRODUCTION

1st 24 hrs. Nat. _____

1st 24 hrs. after shot _____

Gas _____ cu. ft. _____

Dry Hole _____

Abandoned _____

Map No. 28 Sec. 31 Twp. 31 R. 1W

Well No. 7-Karnes Farm


Sinclair-Petroleum Company

990 Ft. from N. Line

330 Ft. from S. Line

330 Ft. from E. Line

 Ft. from W. Line

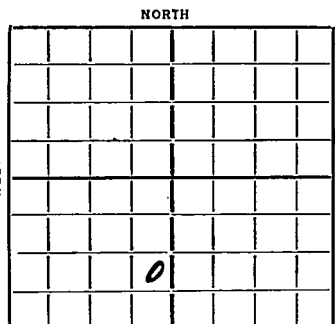

Elev. 1258

REPORT

1936

3/18

Location

3/20

--

3/27

Rign.

4/2

10" - 330' Drlg. 365'

4/10

Drlg. 2483'

4/16

Drlg. 3100'

4/23

Chat 3647', 7" @ 3647' RUST.

4/30

T.D. 3676' 2000 acid.

5/6/36

- Chat 3647'

T.D. 3681'

Flow 343 bbls.

COMPLETED

Map No. 31 Sec. 28 Twp. 31 R. 1W

Well No. 7 - Kansas

Sinclair Prairie Company

Contractor

FIRST REPORT

SECTION PLAT

Ft. from N. Line

990 Ft. from S. Line

330 Ft. from E. Line

Ft. from W. Line

	0		

Location 

Rig up

Drilling and Remarks:

RECORD

Cased _____ in., _____ ft.

Sand _____

Gas _____

Oil _____

Total Depth _____

PRODUCTION

1st 24 hrs. Nat. _____

1st 24 hrs. after shot _____

Gas _____ Cu. Ft.

Dry Hole _____

Abandoned _____

Date
MAR 18 1936

ORVAL MANNSCHRECK

192 _____ Scout

Map No. 31 Sec. 28 Twp. 21 R. 1WWell No. 7 TamasSinclair Prairie Company

Contractor

SECTION PLAT

_____ Ft. from N. Line

990 Ft. from S. Line320 Ft. from E. Line

_____ Ft. from W. Line

COMPLETED

Location _____

Rig up _____

Drilling and Remarks:

Oh 8647Flow 3438 1/2

RECORD

Cased _____ in., _____ ft.

Sand _____

Gas _____

Oil _____

Total Depth 3681

PRODUCTION

1st 24 hrs. Nat. _____

1st 24 hrs. after shot _____

Gas _____ Cu. Ft.

Dry Hole _____

Abandoned _____

Date

MAY 6 1903 19

S. J. LEWIS

Scout