

KANSAS

Map No. _____ Sec. 28 Twp. 31 R. 1-W

Well No. 8-Kansas^M Farm _____

Sinclair-Prairie Company


990 Ft. from N. Line

_____ Ft. from S. Line

330 Ft. from E. Line

_____ Ft. from W. Line

Chs. 1267

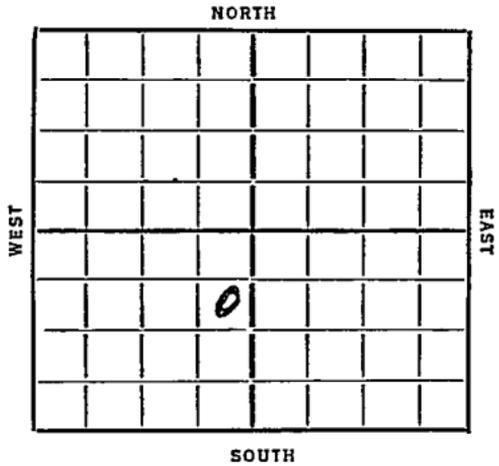

Date	REPORT
1936	
3/25	Moving in
4/2	Rig on ground.
4/10	Drlg. 365'
4/16	Drlg. 2400'
4/23	Drlg. 2490'
4/30	Chat 3648'. Drlg. 3651'.
5/7	Gas 3660' T.D. 3681'-2000 acid.
5/13/36	Chat 3648'.
	T.D. 3651'.
	2000 acid.
	Flow 203 bbls.

COMPLETED

Map No. 31 Sec. 28 Twp. 31 R. 14

Well No. 8 Kansas

Sinclair-Prairie Company

Contractor

SECTION PLAT

		0	

990 Ft. from N. Line

..... Ft. from S. Line

330 Ft. from E. Line

..... Ft. from W. Line

FIRST REPORTS

Location.....

Rig up.....

Drilling and Remarks:

Moving in

RECORD

Cased..... in., ft.

Sand.....

Gas.....

Oil.....

Total Depth.....

PRODUCTION

1st 24 hrs. Nat.....

1st 24 hrs. after shot.....

Gas..... Cu. Ft.

Dry Hole.....

Abandoned.....

Date

8/25/36 192

S. J. LEWIS

Scout

Map No. 31 Sec. 28 Twp. 31 R. 1W

Well No. J Haman

Sinclair-Prairie Company

Contractor

SECTION PLAT

		0	

990 Ft. from N. Line

_____ Ft. from S. Line

1320 Ft. from E. Line

_____ Ft. from W. Line

COMPLETED

Location _____

Rig up _____

Drilling and Remarks:

Chas 3648

2000 acid

Flow 2038 fl

RECORD

Cased _____ in., _____ ft.

Sand _____

Gas _____

Oil _____

Total Depth 3651

PRODUCTION

1st 24 hrs. Nat. _____

1st 24 hrs. after shot _____

Gas _____ Cu. Ft.

Dry Hole _____

Abandoned _____

Date

MAY 13 1936

G. J. LEWIS Scout