


Section 28 Township 31 Range 1-W

Well Number #1 Markley

Company Marathon



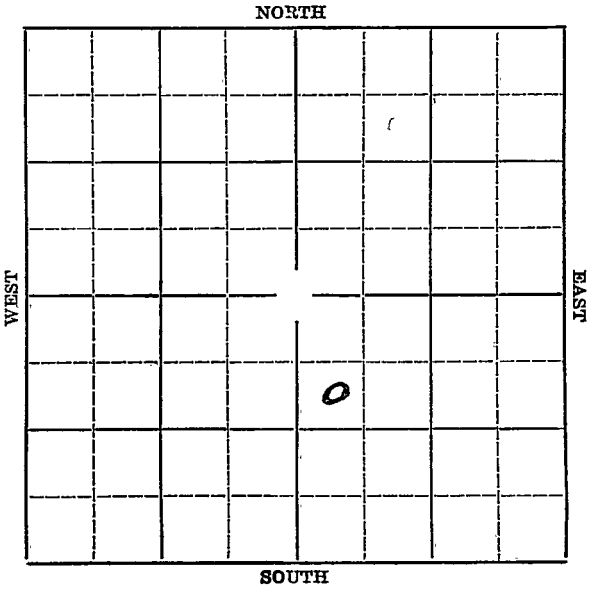

Map No. 31 Sec. 28 Twp. 31 R. 1WWell No. 1 MarkleyMarathon Company

Contractor

## SECTION PLAT

|  |  |   |  |
|--|--|---|--|
|  |  |   |  |
|  |  |   |  |
|  |  | 0 |  |
|  |  |   |  |

990 Ft. from N. Line

\_\_\_\_\_ Ft. from S. Line

\_\_\_\_\_ Ft. from E. Line

330 Ft. from W. Line

## FIRST REPORT

Location \_\_\_\_\_

Rig up \_\_\_\_\_

Drilling and Remarks:

Log.

## RECORD

Cased \_\_\_\_\_ in., \_\_\_\_\_ ft.

Sand \_\_\_\_\_

Gas \_\_\_\_\_

Oil \_\_\_\_\_

Total Depth \_\_\_\_\_

## PRODUCTION

1st 24 hrs. Nat. \_\_\_\_\_

1st 24 hrs. after shot \_\_\_\_\_

Gas \_\_\_\_\_ Cu. Ft.

Dry Hole \_\_\_\_\_

Abandoned \_\_\_\_\_

Date

7/15/36 19 36 D. Lewis Scout

28-31S-1W Well #3 Kamas  
Sinclair-Prairie Oil Co.  
SW NW SE 990' from North line and  
330' feet from west line  
3660 to 3695, 1000 acid, 138 bbls.  
in 24 hours

This ticket I am returning to you  
is on exactly the same spot as a  
completed well. ~~THEXXXXXXXXXXXXXX~~  
~~XXXXXXXXXX~~

Check these two wells. One of them  
is wrong. It may be the old  
producing well.

Sam

|                       |                    |
|-----------------------|--------------------|
| Returned              | <i>[Signature]</i> |
| Cards                 | <i>[Signature]</i> |
| Tracing               | <i>[Signature]</i> |
| France Map            | <i>[Signature]</i> |
| Scarborough Map       | <i>[Signature]</i> |
| Moody Map             |                    |
| Scarborough Plat Book |                    |
| Moody Plat Book       |                    |

Map No. 31 Sec. 28 Twp. 31 R. 14

Well No. 1 Markley

Marathon Company

Contractor

SECTION PLAT

|  |  |   |  |
|--|--|---|--|
|  |  |   |  |
|  |  |   |  |
|  |  |   |  |
|  |  | o |  |
|  |  |   |  |

990 Ft. from N. Line

\_\_\_\_\_ Ft. from S. Line

\_\_\_\_\_ Ft. from E. Line

330 Ft. from W. Line

COMPLETED

Location \_\_\_\_\_

Rig up \_\_\_\_\_

Drilling and Remarks:

Cha 8 3866  
3000 acid  
Pa 8 248

RECORD

Cased \_\_\_\_\_ in., \_\_\_\_\_ ft.

Sand \_\_\_\_\_

Gas \_\_\_\_\_

Oil \_\_\_\_\_

Total Depth 36 89

PRODUCTION

1st 24 hrs. Nat. \_\_\_\_\_

1st 24 hrs. after shot \_\_\_\_\_

Gas \_\_\_\_\_ Cu. Ft.

Dry Hole \_\_\_\_\_

Abandoned \_\_\_\_\_

Date

AUG 26 1936

19

S. J. LEWIS Scout

*[Handwritten signature]*

|                       |                    |
|-----------------------|--------------------|
| Returned              | <i>[Signature]</i> |
| Cards                 | <i>[Signature]</i> |
| Tracing               | <i>[Signature]</i> |
| France map            | <i>[Signature]</i> |
| Scarborough Map       | <i>[Signature]</i> |
| Moody Map             | <i>[Signature]</i> |
| Scarborough Plat Book |                    |
| Moody Plat Book       |                    |