

Map No. KANSAS Sec. 28 Twp. 31 R. 1WWell No. 1-2 Markley FarmVickers But Company

NORTH

WEST

EAST

SOUTH

Location _____

Drilling Remarks _____

Rig Up _____

Drilling Remarks _____

RECORD

Cased _____ in. _____ ft.

Sand _____

Gas _____

Oil _____

Total Depth _____

PRODUCTION

1st 24 hrs. Nat. _____

1st 24 hrs. after shot _____

Gas _____ cu. ft. _____

Dry Hole _____

Abandoned _____

COMPLETED

KANSAS

Map No. 31 Sec. 28 Twp. 31 R. 1WWell No. 1 - Markley
Vickers Company

Contractor

TEST RESULTS

SECTION PLAT

		0	

Ft. from N. Line

330 Ft. from S. Line

Ft. from E. Line

330 Ft. from W. LineLocation ✓

Rig up

Drilling and Remarks:

RECORD

Cased.....in.,ft.

Sand.....

Gas.....

Oil.....

Total Depth.....

PRODUCTION

1st 24 hrs. Nat.....

1st 24 hrs. after shot.....


Gas.....Cu. Ft.

Dry Hole.....

Abandoned.....

Date

12-4-35 192..... Scout

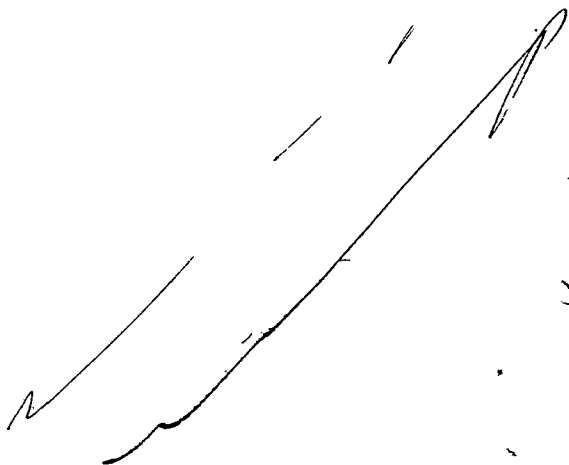

Returned	
Cards	
Tracing	
France Map	
Scarborough Map	
Moody Map	
Scarborough Plat Book	
Moody Plat Book	

Map No. 31 Sec. 28 Twp. 31 R. 14

Well No. 1 Markley

Vickers Pat Company

Contractor

SECTION PLAT

Ft. from N. Line

330 Ft. from S. Line

Ft. from E. Line

330 Ft. from W. Line

COMPLETED

Location

Rig up

Drilling and Remarks:

2000 acid

flowed 357

RECORD

Cased _____ in. _____ ft.

Sand Chat 36.38

Gas _____

Oil _____

Total Depth 368.3

PRODUCTION

1st 24 hrs. Nat. _____

1st 24 hrs. after shot _____

Gas _____ Cu. Ft.

Dry Hole _____

Abandoned _____

Date

JAN 22 1926

Scout

CFV & MANNSCHECK

Returned _____
 Cards _____
 Tracing _____
 France Map _____
 Scarborough Map _____
 Moody Map _____
 Scarborough Map _____
 A good place for _____