Harper


KANSAS

SECTION 28 TOWNSHIP 31S RANGE 5W

WELL NO. #1 Heibert

COMPANY Natural Gas & Oil

NORTH SW SW SE

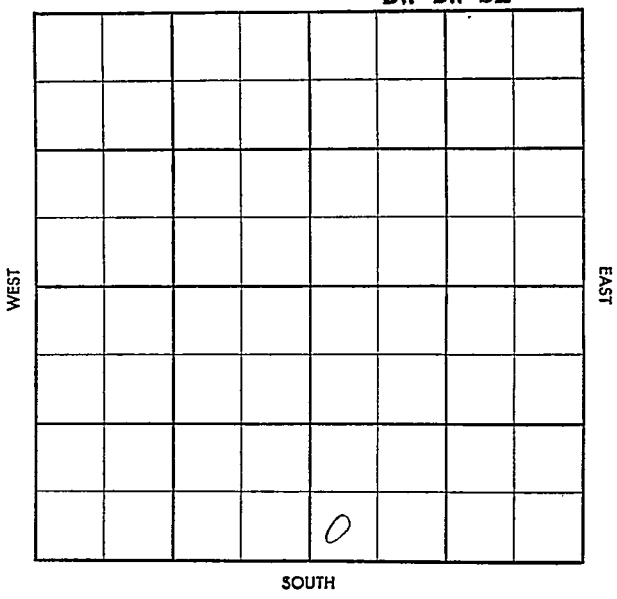

FORM 504-3 SUNRAY

S-513-B

Co.

County Harper Elev.

Sec. 28 Twp. 31 Rge. 5W

Company Natural Gas & Oil

Farm Name Heibert No. 1

TOPS	DEPTH	LOG	DATUM
Anh.			
Tp.			
H.			
Tr.			
Dg.			
B.L.			
L.			
K.C.			
B.K.C.			
Ce.			
C.			
M.			
M.			
K.			
Mz.			
Mq.			
V.			
S.			
S.			
A.			
R.			
Pf.			
G.			
T.D.			


Loc. in Sec. SW SW SE

Geol.

Contr. Strata #1

Lse.

Pool Garber

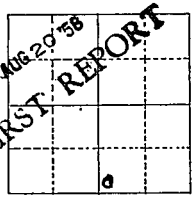

No.


Date Comm. 8-14-58

Sec.

8" @ 351 w/250, SD @ 2280 for repairs.

T.

R.

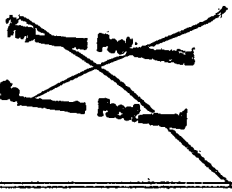

S-513-B

County Harper Elev. 1332DF 1335RB

Sec. 28 Twp. 31 Rge. 5W

Company Natural Gas & Oil

Farm Name Heibert No. 1

TOPS	DEPTH	LOG	DATUM
Anh.			
Tp.			
H.			
Tr.			
Dg.			
B.L.			
L.			
K.C.	3571	3574	
B.K.C.		3799	
Ce. Marm		3873	
C.			
M.	4186	4188	
M.			
K. sh	4533	4549	
Mz.			
Mq.			
V.			
S. sd	4648	4651	
S.			
A.			
R.			
Pf.			
G.			
T.D.	4673	4677	

Loc. in Sec. SW SW SE

Geol.

Contr. Strata #1

Lse.

Pool Garber

ABANDONED

SEP 10 '58

No.

Date Comm. 8-14-58

Sec.

8" @ 351 w/250, SD @ 2280 for repairs.

AUG 27 '58 ϕ4728 SEP 3 '58 DST 3709-18 1hr 600' gip 600' oil 6 gcm + 60 O & gcw BHP 1210/20" DST 3740-55 1hr 2500' gip 115 gc + 500M +180 gcw BHP 1475/20" DST 4649-53 1hr 5'M BHP 1410/20" DST 4653-63 1hr 10'M BHP 1280/20" ϕ 4665 D & A

T.

R.