

KANSAS


FORM 51 5M BR1X

Barber County

Section 29 Township 31 Range 11W

Well No. #2 Whelan "B"

Company Joe Aylward

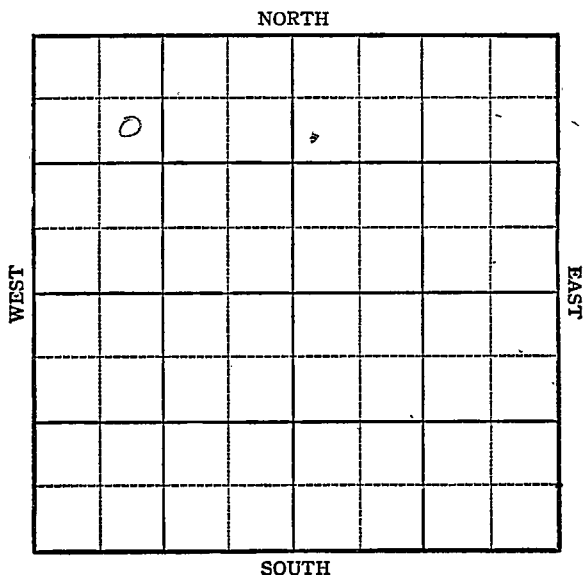

Barber Co.

Whelan

KANSAS

Sec. 29 Twp. 31 R. 11W

Well No. 2 Whelan "B" Farm

Joe Aylward Company

SE NW NW


990 Ft. from N. Line

 Ft. from S. Line

 Ft. from E. Line

990 Ft. from W. Line

Flow. 1619

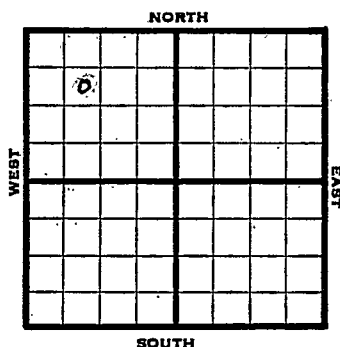

1944

REPORT

9-13	8" 125 Drilling 2200
9/21	Drlg. 3635
9/28	Miss 4367-71 TD Run 5"
10/4	5" @ 4356 Drlg. 4382
10/11	TD 4396 flow 59 oil in 15 hrs.
10/18	" " " " " " "
10/25	Lans 3805 5" @ 4356 Miss 4367 Pump 100 Pot. Grav. 36.4 TD 4403

COMPLETED

Pool Name WhelanMap No. NS 45 / Sec. 29 Twp. 31 R. 11WWell No. 2 Whelan "B"Joe Aylward

Company

FIRST REPORT

Contractor

SE NW NW

SECTION PLAT

990


Ft. from N. Line

Ft. from S. Line

Ft. from E. Line

990

Ft. from W. Line

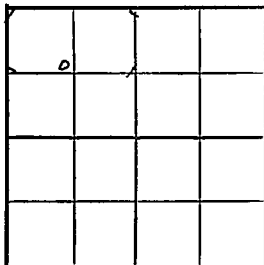Barber

Location

Rig up

Drilling and Remarks:

8" 125
2200

RECORD

Cased _____ in., _____ ft.

Sand

Gas

Oil

Total Depth

PRODUCTION

1st 24 hrs. Nat.

1st 24 hrs. after shot

Gas _____ Cu. Ft.

Dry Hole

Abandoned

Date

SEP 13 1944

19


S. J. LEWIS Scout

Pool Name WhelanMap No. 61 **KANSAS** Sec. 29 Twp. 31 R. 11WWell No: 2 Whelan "B"Joe Aylward

Company

COMPLETED

Contractor

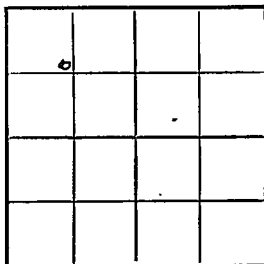SE NW NW**SECTION PLAT**990 Ft. from N. Line Ft. from S. Line Ft. from E. Line990 Ft. from W. Line**Barber County**Location Rig up

Drilling and Remarks:

*Loss 3805**5" @ 4356**Loss 4367**Prof. 100 ft**36 1/2 ft***RECORD**Cased in, ft.Sand Gas Oil Total Depth 4403**PRODUCTION**1st 24 hrs. Nat. 1st 24 hrs. after shot Gas Cu. Ft. Dry Hole Abandoned

Date

OCT 25 1944

19

S. J. LEWIS Scout