

O.W.W.O.

Section 29 Township 31 Range 11WWell No. #1 Whelan "C"Company Globe Oil & Ref.

NORTH

				0			


WEST

EAST

SOUTH

Sec. 29 Twp. 31 R. 11WWell No. #1 Whelan FarmGlobe Oil & Ref. CompanyAylward Drlg. ContractorWhelan Pool Ft. from N. Line330 Ft. from S. Line Ft. from E. Line330 Ft. from W. Line

SW SW NE

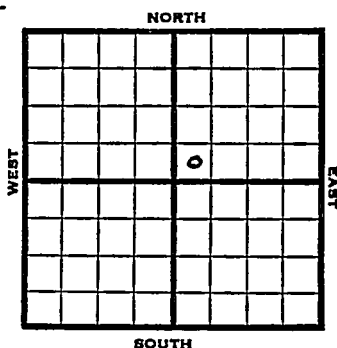

1953

Elev. 1615' REPORT

5/27

Spud 5-23-53

8" @ 126'

Drlg. 1620'

6/3

DST in Top 2887-2975, 3/4 hr, 30' M 1020#

Drlg. 3415

6/10

Top 2831 Elgin Zone 3437

Elgin sd 3485'

DST 3435-96', 3/4 hr, 270' SW 1290#

Doug 3620 DST 3619-60, 1/2 hr,

75' SW 150# Lans 3791

Drlg.

6/17

Spud 5-23-53 D & A TD 4472

8" @ 126'

DST 2887-2975 open 3/4 hr rec 30' mud

1020# Top 2831 Elgin zone 3437

Elgin sd 3485'

DST 3435-96 open 3/4 hr rec 270' SW

1290# Doug. 3620

DST 3619-60 open 1/2 hr rec 75' SW 150#

Lans 3791 Miss 4357

DST 4355-67 open 1 hr rec 30' mud 915#

DST 4349-77 open 1 hr gas in 55 min

rec 132' SGCM 555#

DST 4357-87 open 1 1/4 hr rec 162' mud

1000#

DST 4349-97 open 1 1/4 hr rec 225' GCM

415#

OVER

1953

6/17

(Information continued)

DST 4349-4417 open 1 hr rec 270' mud
420#

DST 4349-4437 open 1 hr rec 2000'
gas, 240' SGCM 430#

TD 4472 D & A

ABANDONED

County Barber State Kansas
 Sec. 29 (Blk. 31 (Sur. 11W Map No.
 (Twp.) (Rge.)
 Operator Globe Oil & Ref.
 Well No. 1 Farm Whelan
 Elev. _____ Location SW SW NE

FIRST REPORT

330 Ft. From S Line NE
 330 Ft. From W Line Quarter

1st. Report MAY 27 1953

Completion _____

Remarks _____

Aylward Drlg. - Contr.

Spudding Date 5-23-53

Drlg. Data Whelan Pool

8" @ 126 drlg. 1620


J. G. McGEHEE

Secret Carte	
Land Small Map	
Land West Map	
Tracings	
France Map	
Pierce Map	
Misc.	

JUN 1 1953

Drig. Data

County Barber State Kansas
 Sec. 29 (Blk. Twp.) 31 (Sur. Rge.) 11W Map No.
 Operator Globe Oil & Ref.
 Well No. 1 Farm Whelan
 Elev. 1615 Location SW SW NE

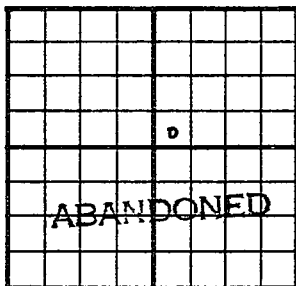

330 Ft. From S Line NE

330 Ft. From W Line Quarter

1st. Report

Completion JUN 17 1953

Remarks Whelan Pool

Aylward Drlg. - Contr.

Spudding Date 5-23-53

Drlg. Data D & A TD 4472

8" @ 126 DST 2887-2975 open 3/4 hr.

Rec. 30' mud 1020# Top. 2831

Elgin zone 3437 Elgin sd. 3485

DST 3435-96 open 3/4 hr. Rec. 270' sw

1290# Doug. 3620 DST 3619-60 open 1/2 hr

Rec. 75' sw 150# Lans. 3791 Miss. 4357

DST 4355-67 open 1 hr. Rec. 30' mud

915# DST 4349-77 open 1 hr. Gas in

55 min. Rec. 132' sgcm 555# DST 4357-

87 open 1 1/4 hr. Rec. 162' mud 1000#

DST 4349-97 open 1 1/4 hr. Rec. 225' gcm

415# DST 4349-4417 open 1 hr. Rec.

270' mud 420# DST 4349-4437

open 1 hr. Rec. 2000' gas 240' sgcm

J. G. McGEHEE

Orig. Data

430#

TD 4472

Scout Cards *mmmm*
Land Small Map
Land Wall Map *3.3*
Tracings.....
France Map
Pierce Map
Misc.....

JUN 23 1953

O.W.W.O.

FORM 513 SUNRAY

County Barber Elev. _____
 Sec. 29 Twp. 31 Rge. 11W
 Company Globe Oil & Refinery
 Farm Name Whelan "C" No. 1

TOPS	DEPTH	LOG	DATUM
------	-------	-----	-------

Anh.			
Tp.	2831		
H.			
Tr.			
Dg.	3620		
BL.			
L.	3791		
K.C.			
B.K.C.			
Ce.			
C.			
M.	4357		
M.			
K.			
Mz.			
Me.			
V.			
S.			
S.			
A.			
R.			
Pe.			
G.			
T.D.			

Loc. in Sec. _____

SW SW NE

O.W.W.O.

Geol. O.W.W.O.

Contr. _____

Sterling Drilg

Pool

Whelan

FIRST REPORT

FEB 13 '57

Date Comm. _____

OTD 4472 was D & A

Spud 2/13/57

26

Co.

County Barber

Elev. _____

Sec. 29Twp. 31Rgs. 11WCompany Globe Oil & RefineryFarm Name Whelan "C"No. I

TOPS	DEPTH	LOG	DATUM	Loc. in Sec.
Anh.				SW SW NE
TP.	2831			
H.				<u>OWWO</u>
Tr.				
Dg.	3620			
BI.				
L.	3791			Geol. _____
K.C.				Contr. _____
BKC.				
Ce.				Sterling Drlg
C.				Pool
M.	4357			Whelan
M.				
K.				
Mz.				
Ma.				
V.				
S.				
S.				
A.				
R.				
Pe.				
G.				
TD.	4485			COMPLETE

Date Comm. _____

OTD 4472 was D & A

Spud 2/13/57 FEB 20 '57 DD 4485

5 1/2 4478 127 CO 4448

112/4364-92 M2 FRAC

MAR 6 '57 P. Ld + 100 MCF GPD

MAR 13 '57

P 3780 + 20 BW PD

G2 139 MCF

No.

Sec.

T.

R.