


Section 29 Township 31 Range 11W

Well No. #2 Weiland (Whelen)

Company Aylward Drlg.

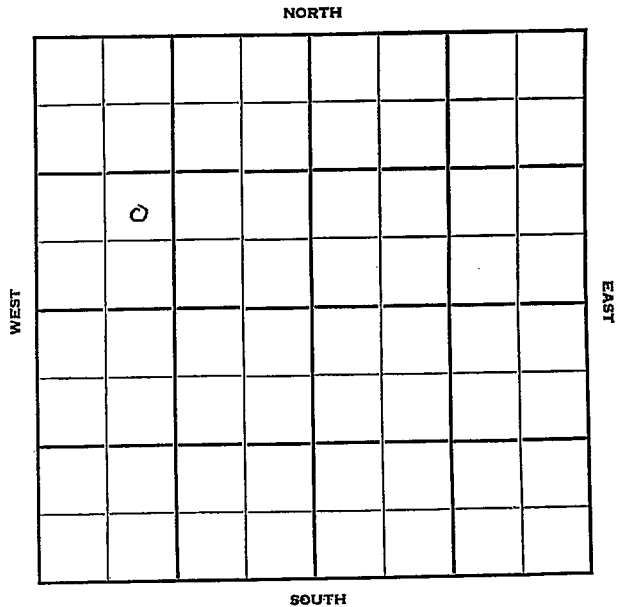

Barber

KANSAS

Sec. 29 Twp. 31 R. 11W

Well No. #2 Weiland Farm

Aylward Drlg. Company

Aylward Drlg. Contractor


_____ Ft. from N. Line

990 Ft. from S. Line

_____ Ft. from E. Line

990 Ft. from W. Line

NE SW NW

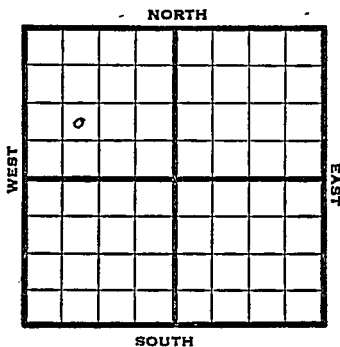

1952

Elev. 1606' REPORT

2/20

MIR

3/4

Drlg. 4205'

3/12

RTD 4355 Miss Chat 4351
5" @ 4355 MICT

3/19

CO. POP

4/2

Spud 2-20-52
Oil Well TD 4386
8" @ 120
Miss. 4351 5" @ 4355
TD 4355 Lans. 3781 DD 4386
FU 2600' fluid 14 hr. S/ 36 bo
29 bw 12 hr. S/ 5 BFPH 3 hr.
50% wtr. Comp. 25 bopd 15 bw

COMPLETED

County Barber State Kansas

Sec. 29 (Blk. Twp.) 31 (Sur. Rge.) 11W Map No.

Operator Aylward Drlg.

Well No. 2 Farm Weiland

Elev. 1606 Location NE SW NW

| | | | | | | | |
|---|--|--|--|--|--|--|--|
| | | | | | | | |
| | | | | | | | |
| 0 | | | | | | | |
| | | | | | | | |
| | | | | | | | |
| | | | | | | | |
| | | | | | | | |
| | | | | | | | |

COMPLETE

990 Ft. From S Line NW

990 Ft. From W Line Quarter

1st. Report

Completion APR 2 1952

Remarks

Aylward Drlg. - Contr.

Spudding Date 2-20-52

Drlg. Data Oil well TD 4386

8" @ 120 Miss. 4351 5" @ 4355 TD 4355

Lans. 3781 DD 4386 FU 2600' fluid 14 hr

S/ 36 bo 29 bw 12 hr. S/ 5 bfph 3 hr.

50% water Comp. 25 bopd 15 bw