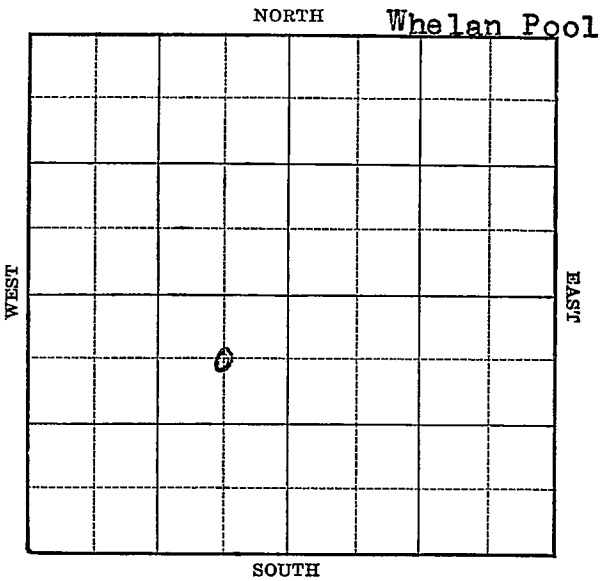


Section 29 Township 31 Range 11-WWell No. #1 Whelan "B"Company Lario Oil & Gas

KANSAS

Barber


Sec. 29 Twp. 31 R. 11-WWell No. #1 Whelan "B" FarmLario Oil & Gas

Company

(Whelan)

660 Ft. from N. Line         Ft. from S. Line660 Ft. from E. Line         Ft. from W. Line

Elev. 1554

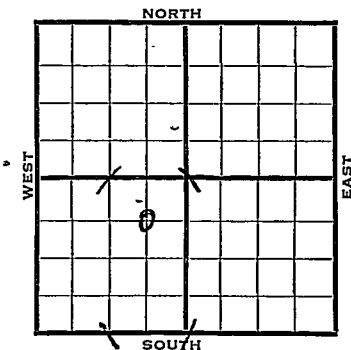

| 1940 | REPORT                                     |
|------|--------------------------------------------|
| 5/22 | Location                                   |
| 5/29 | "                                          |
| 6/6  | "                                          |
| 6/13 | "                                          |
| 6/20 | "                                          |
| 6/27 | "                                          |
| 7/3  | "                                          |
| 7/11 | "                                          |
| 7/18 | Derrick.                                   |
| 7/25 | 10" - 132' Drlg. 600'                      |
| 8/2  | Drlg. 2550'                                |
| 8/8  | Lans. 3730' Drlg. 3780'                    |
| 8/14 | Miss. 4309-5" - 4311-13 T.D.               |
|      | R.U.S.T.                                   |
| 8/22 | T.D. 4338' 450' fluid 4 hrs.               |
| 8/29 | Swab 21 oil & 6 water 5 hrs<br>off bottom. |
| 9/5  | C. O.                                      |
| 9/12 | Drlg. 4346'                                |
| 9/19 | 4358' water sand.                          |
| 9/26 | " " "                                      |
|      | OVER                                       |

1940

10/3 4358' water sd.

10/9 Miss. 4309'

5" - 4311'

T.D. 4358'

Shot 135 qts.

Water.

ABANDONED

Map No. 61 Sec. 29 Twp. 31 R. 11WWell No. 1 Whelan "B"Lario Oil & Gas

Company

Contractor

## FIRST REPORT

C NE SW

660 Ft. from N. Line


Ft. from S. Line

660 Ft. from E. Line

Ft. from W. Line

WHELAN POOL

## SECTION PLAT

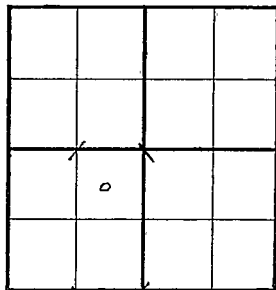Location X

Rig up \_\_\_\_\_

Drilling and Remarks: \_\_\_\_\_

## RECORD

Cased \_\_\_\_\_ in., \_\_\_\_\_ ft.

Sand \_\_\_\_\_

Gas \_\_\_\_\_

Oil \_\_\_\_\_

Total Depth \_\_\_\_\_

## PRODUCTION

1st 24 hrs. Nat. \_\_\_\_\_

1st 24 hrs. after shot \_\_\_\_\_

Gas \_\_\_\_\_ Cu. Ft.

Dry Hole \_\_\_\_\_

Abandoned \_\_\_\_\_

Date

MAY 22 1940 19S. J LEWIS

Scout

|                  |       |
|------------------|-------|
| Misc Small Maps  | ..... |
| Cards            | ..... |
| Tracing          | ..... |
| France Map       | ..... |
| Scarborough Map  | ..... |
| Moody Map        | ..... |
| Geological Dept. | ..... |
| Moody Flat Book  | ..... |

Map No. 61 Sec. 29 Twp. 31 R. 11WWell No. 1 Whelan "B"Lario Oil & Gas Company ContractorABANDONED  
C NE SW660 Ft. from N. Line Ft. from S. Line660 Ft. from E. Line Ft. from W. Line

## SECTION PLAT

|  |  |  |  |
|--|--|--|--|
|  |  |  |  |
|  |  |  |  |
|  |  |  |  |
|  |  |  |  |

WHELAN POOL

Location Rig up 

Drilling and Remarks:

*Miss 4309**5" @ 4311**Shot 1359 to.**Water.*

## RECORD

Cased  in.,  ft.Sand Gas Oil Total Depth 4358

## PRODUCTION

1st 24 hrs. Nat. 1st 24 hrs. after shot Gas  Cu. Ft.Dry Hole Abandoned 

Date

OCT 9 1940 19

S. J. LEWIS Scout

*DAN*

|                       |            |
|-----------------------|------------|
| Misc Small Maps       | <i>DAN</i> |
| Cards.....            | <i>DAN</i> |
| Tracing.....          | <i>DAN</i> |
| France Map.....       | <i>DAN</i> |
| Scarborough Map.....  | <i>DAN</i> |
| Moody Map.....        | <i>DAN</i> |
| Geological Dept. .... |            |
| Moody Flat Book       |            |