



Sec. 29 Twp. 31 R. 11W

Well No. #1 Whelan Farm

Max Beren

~~Glen Phelan~~

Company

**Whelan**


990 Ft. from N. Line

\_\_\_\_\_ Ft. from S. Line

\_\_\_\_\_ Ft. from E. Line

330 Ft. from W. Line

SW NW NW

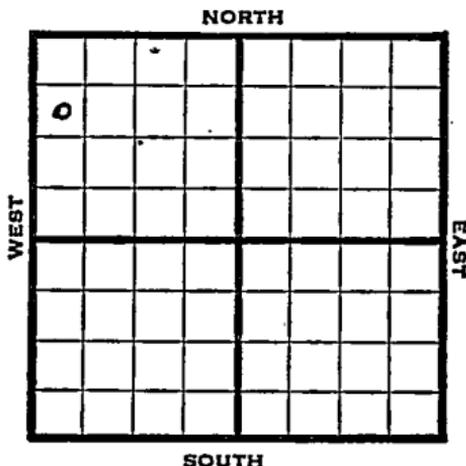

Elev. 1605' REPORT

1947

9/24

8" @ 159'  
Drlg. 575'

10/1

Drlg. 2796'

10/8

Mississippi 4344'  
TD 4349'  
5" @ 4346'  
RUST

10/15

TD 4389'  
30 qts 4357-89  
CO

10/22

TD 4390 Pump 15 bbls oil a day

10/29

"

11/5

"

11/12

"

11/25

Mississippi 4344  
5" @ 4346  
30 Qts.  
Pump 50 oil / 30 W  
Pot.  
TD 4390  
Gravity 39

**COMPLETED**

**OVER**

1955  
11/2

# O. W. P. B.

OTD 4390'.

Old tops: Dodge 3628', Miss. 4344'  
5" @ 4346' OTD 4390'

PB 33/3630-38 COMPLETED: 10,544  
MCFGPD.

**FIRST REPORT  
COMPLETED**

Map No. \_\_\_\_\_ Sec. 29 Twp. 31 R. 11W

Well No. 1 Whelan

Glen Phelan Company

FIRST REPORT

Contractor

SW NW NW

SECTION PLAT

990 Ft. from N. Line

\_\_\_\_\_ Ft. from S. Line

\_\_\_\_\_ Ft. from E. Line

330 Ft. from W. Line


Barber County

Location \_\_\_\_\_

Rig up \_\_\_\_\_

Drilling and Remarks:

8" @ 159

drlg. 575

RECORD

Cased \_\_\_\_\_ in., \_\_\_\_\_ ft.

Sand \_\_\_\_\_

Gas \_\_\_\_\_

Oil \_\_\_\_\_

Total Depth \_\_\_\_\_

PRODUCTION

1st 24 hrs. Nat. \_\_\_\_\_

1st 24 hrs. after shot \_\_\_\_\_

Gas \_\_\_\_\_ Cu. Ft.

Dry Hole \_\_\_\_\_

Abandoned \_\_\_\_\_

Date

SEP 24 1947 19

S. J. LEWIS

Scout

*Wm*

Misc. Small Maps	<i>2</i>
Cards	<i>100</i>
Tracing	<i>1</i>
France Map	<i>1</i>
Scarborough Map	<i>1</i>
Pierce Map	<i>1</i>
Geological Dept.	<i>1</i>
Pierce Plat Book	<i>1</i>

Map No. 61 Sec. 29 Twp. 31 R. 11W

Well No. 1 Whelan

Glen Whelan Company

**COMPLETE**

Contractor

SW NW NW

*E 11605*  
**SECTION PLAT**

990 Ft. from N. Line

\_\_\_\_\_ Ft. from S. Line

\_\_\_\_\_ Ft. from E. Line

330 Ft. from W. Line


Barber County

Location \_\_\_\_\_

Rig up \_\_\_\_\_

Drilling and Remarks:

*Miss 4344*  
*5' 1" 4346*  
*300 to*  
*Run 50 oil + 300 W*  
*Bo X*  
*39 2/3*

**RECORD**

Cased \_\_\_\_\_ in., \_\_\_\_\_ ft.

Sand \_\_\_\_\_

Gas \_\_\_\_\_

Oil \_\_\_\_\_

Total Depth 4890

**PRODUCTION**

1st 24 hrs. Nat: \_\_\_\_\_

1st 24 hrs. after shot \_\_\_\_\_

Gas \_\_\_\_\_ Cu. Ft.

Dry Hole \_\_\_\_\_

Abandoned \_\_\_\_\_

Date

NOV 25 1947

19

S. J. LEWIS

Scout

*Wm*

Misc. Small Maps  
Cards *Elaine*  
Tracing *P*  
France Map *L*  
Scarborough Map *L*  
Pierce Map *L*  
Geological Dept.  
Pierce Plat Book

# O. W. P. B.

FORM 513 REV. SUNRAY

OWPB

County	Barber	Elev.	1605
Sec.	29	Twp.	31
		Rgn.	11W
Company	Max Beren (Glenn Peel et al.)		
Farm Name	Whelan	No.	1

TOPS	DEPTH	LOG	DATUM	Loc. in Sec.
Anh.				SW NW NW
Tr.				
H.				
Tr.				
Dg.	3628			
Bl.				
L.				Geol.
K.C.				Contr.
B.K.C.				
Ce.				
C.	4344			Pool
M.				
M.				
K.				
Mz.				
Ma.				
V.				
S.				
S.				
A.				
R.				
Pe.				
G.				
T.D.				

0

FIRST REPORT

NOV 2 '55

COMPLETE

Date Comm. 5<sup>th</sup> @ 4346 OTD 4390 PB 33/ 3630-38

Comp. 19,544 mc fgd

A

Co. Lse. No. Sec. T. R.

Scout Cards *mm*  
Land Small Map .....  
Land Wall Map .....  
Tracings .....  
Picture Map .....  
Pictos Map .....  
Misc. ....

NOV 9 1955