FORM 51 10M 2-49 PETROL

KANSAS

Steyens

Section 29 Township 31 Range 36W

Well No. 1 Reynolds

Company Texas & Columbian Fuel

Hugoton

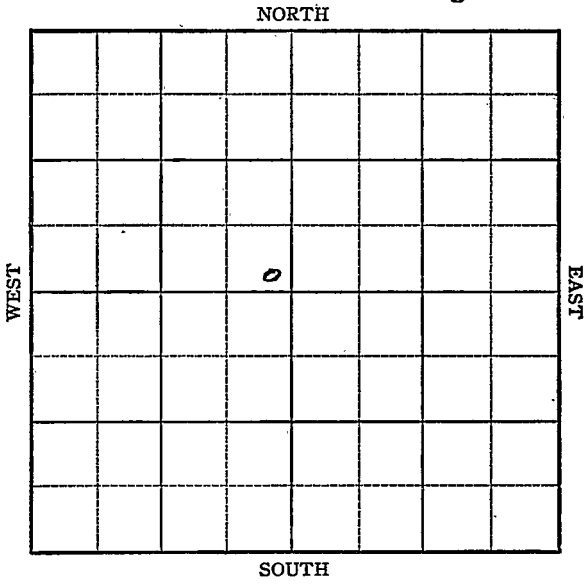

FORM 252-A
5M 10-48 PETROL

Stevens KANSAS

Sec. 29 - Twp. 31 R. 36W

Well No. #1 Reynolds Farm

Texas & Columbian Fuel Company

Hugoton Pool

_____ Ft. from N. Line

165' Ft. from S. Line

165' Ft. from E. Line

_____ Ft. from W. Line

SE NW

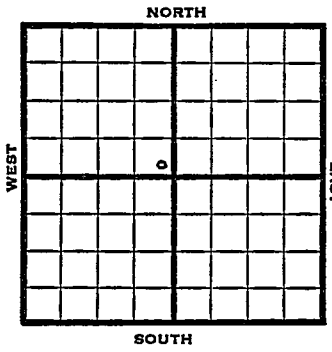


| 1949 | Elev 3061' REPORT |
|---|---|
| 8/10 | Location |
| 8/17 | 10"@ 600'<br>Drlg. 1940' |
| 8/24 | TD 2833-7" @ 2832' |
| 8/31 | 468 shots 2680-2792<br>5500 acid |
| 9/7 | 180 shots 2628-58<br>Acid 26,000 |
| 9/14 | TD 2833'<br>7"@ 2832'<br>Perf<br>3,500 acid<br>31,968,000 Gas<br>412# R Pr.<br>Comp |
| | COMPLETED |

Form 26 200 Bks. 6-49 Petrol

Kansas

Hugoton Pool

Map No. ____ Sec. 29 Twp. 31 R. 36W

Well No. 1 Reynolds

Texas & Columbian Fuel Company

Contractor

SE NW

FIRST REPORT

SECTION PLAT

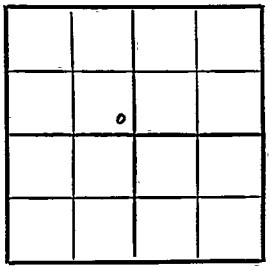

____ Ft. from N. Line

165 Ft. from S. Line

165 Ft. from E. Line

____ Ft. from W. Line

Stevens County

Location X

Rig up

Drilling and Remarks:

RECORD

Cased ____ in., ____ ft.

Sand

Gas

Oil

Total Depth

PRODUCTION

1st 24 hrs. Nat.

1st 24 hrs. after shot

Gas ____ Cu. Ft.

Dry Hole

Abandoned

Date

AUG 10 1949 19

S. J. LEWIS Scout

Form 26 200 Bks. 6-49 Petrol

Kansas

Hugoton Pool

Map No. 1 Sec. 29 Twp. 31 R. 36W

Well No. 1 Reynolds

Texas & Columbian Fuel Company

COMPLETE Contractor

SE NW

EL 3061

SECTION PLAT

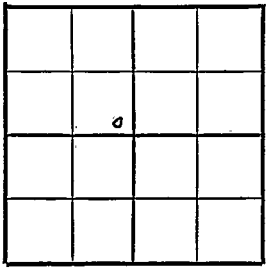

Ft. from N. Line

165 Ft. from S. Line

165 Ft. from E. Line

Ft. from W. Line

Stevens County

Location

Rig up

Drilling and Remarks:

7"@2832

Perf.

3/500 acid

31,965,000 Mcf

412 RP

RECORD

Cased in., ft.

Sand

Gas

Oil

Total Depth 2833

PRODUCTION

1st 24 hrs. Nat.

1st 24 hrs. after shot

Gas Cu. Ft.

Dry Hole

Abandoned

Date

SEP 14 1949 19

S. J. LEWIS Scout