


## FORM 51 5M PETROL

Section 29 Township 31 Range 14-W

Well No. #1 Skinner "B"

Company Deep Rock

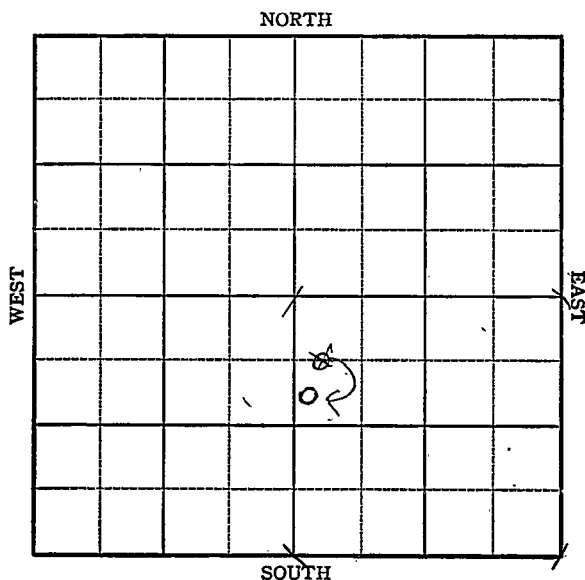


KANSAS

Barber

Sec. 29 Twp. 31 R. 14-WWell No. #1 Skinner "B" FarmDeep Rock Company990660 Ft. from N. Line

Ft. from S. Line

Ft. from E. Line

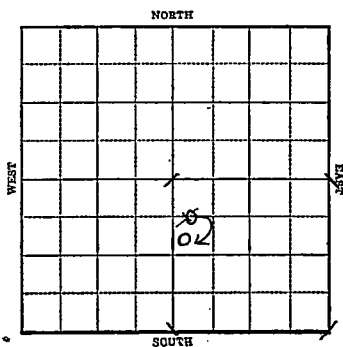210330 Ft. from W. LineElev. 1854

1943

## R E P O R T

9/15 Location

9/22 "

9/29 "

10/6 "

10/13 Surface hole

10/20 12" @ 213  
Drlg. 2110'

10/27 Drlg. 3010'

11/3 Anhy 745  
Drlg. 3850'11/10 Topeka 3150  
Douglas 3850  
Lans 4048  
SSO 4120-35  
Drlg. 4450'

11/17 Viola 4624

Td 4640

5" @ 4626

Rust

11/24 " "

12/1 2000 acid

12/8 5000 acid Pump 150 oil 16 hrs.

OVER

1943

12-15 500' acid pump 151 oil 16 hr.

12/22 " " " "

12/29 " " "

1944 " "

1-5 " "

1-12 TD 4640'

1/19 " "

1/26 Flow 7 oil per hr

2/2 Pumping unit.

2/8 " "

2/16 5" @ 4626

Viola 4624

TD 4640

700 acid

Pump 278 Pot.

Gravity 36.4

COMPLETED

KANSAS 1872 Map No. 1872 Sec. 29 Twp. 31 R. 14W

Well No. 1 Skinner "B"

Deep Rock Company

FIRST REPORT

Contractor

C W L NW SE


SECTION PLAT

660 Ft. from N. Line

Ft. from S. Line

Ft. from E. Line

330 Ft. from W. Line

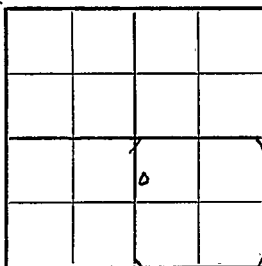

Wildcat

Location X

Rig up

Drilling and Remarks:

RECORD

Cased \_\_\_\_\_ in., \_\_\_\_\_ ft.

Sand \_\_\_\_\_

Gas \_\_\_\_\_

Oil \_\_\_\_\_

Total Depth \_\_\_\_\_

PRODUCTION

1st 24 hrs. Nat. \_\_\_\_\_

1st 24 hrs. after shot \_\_\_\_\_

Gas \_\_\_\_\_ Cu. Ft.

Dry Hole \_\_\_\_\_

Abandoned \_\_\_\_\_

Date

SEP 15 1943 19 S. J. LEWIS Scout

Misc Small Maps

Cards

Tracing

France Map

Scarborough Map

Moody Map

Geological Dept.

Moody Flat Book

KANSAS  
Map No. 672 Sec. 29 Twp. 31 R. 14W


Well No. 1 Skinner "B"

Deep Rock Company

CORRECTION Contractor

SW NW SE

### SECTION PLAT

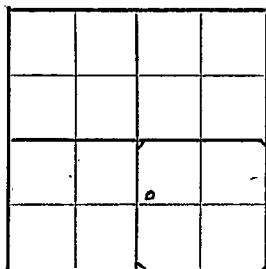

990 Ft. from N. Line

       Ft. from S. Line

       Ft. from E. Line

210 Ft. from W. Line

Wildcat

Location                                 

Rig up                                 

Drilling and Remarks:

Reported

C W L NW SE

### RECORD

Cased            in.,            ft.

Sand                                 

Gas                                 

Oil                                 

Total Depth                                 

### PRODUCTION

1st 24 hrs. Nat.                                 

1st 24 hrs. after shot                                 

Gas            Cu. Ft.


Dry Hole                                 

Abandoned                                 

Date

OCT 13 1943 19

S. J. LEWIS Scout

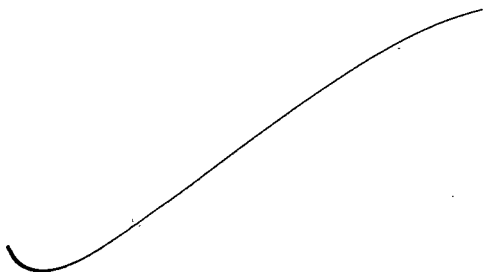

|                   |             |
|-------------------|-------------|
| Misc. Small Maps  | <i>Orma</i> |
| Cards             | <i>Bach</i> |
| Tracing           | <i>WEL</i>  |
| France Map        | <i>✓</i>    |
| Scarborough Map   | <i>✓</i>    |
| Pierce Map        | <i>✓</i>    |
| Geological Dept.  | <i>✓</i>    |
| Pierce Plat. Book | <i>✓</i>    |

Map No. 92 Sec. 29 Twp. 31 R. 14W

Well No. 1 Skinner "B"

Deep Rock Company

COMPLETED Contractor

SW NW SE

# SECTION PLAT

990 Ft. from N. Line

|  |  |  |  |
|--|--|--|--|
|  |  |  |  |
|  |  |  |  |
|  |  |  |  |
|  |  |  |  |
|  |  |  |  |

         Ft. from S. Line

         Ft. from E. Line

210 Ft. from W. Line

**Wild cat**

Location         

## RECORD

Rig up         

Cased          in.,          ft.

Drilling and Remarks:

Sand         

Gas         

Oil         

Total Depth 4640

*Via 4624*

*5" 4626*

*7000 acid*

*Pump 2780*

## PRODUCTION

1st 24 hrs. Nat.         

1st 24 hrs. after shot         

Gas          Cu. Ft.

Dry Hole         

Abandoned         

*36 1/2 ft*

Date

FEB 16 1944 19

S. J. LEWIS Scout

Misc Small Maps *Oma*  
 Cards *Madge*  
 Tracing *WEL*  
 France Map *✓*  
 Scarborough Map *✓*  
 Moody Map *✓*  
 Geological Dept. \_\_\_\_\_  
 Moody Plat Book \_\_\_\_\_