

Barber County

Skinner Pool


FORM 51 10M 12-46 PETROL

KANSAS

Section 29 Township 31 Range 14W

Well No. 3 Skinner "B"

Company Deep Rock

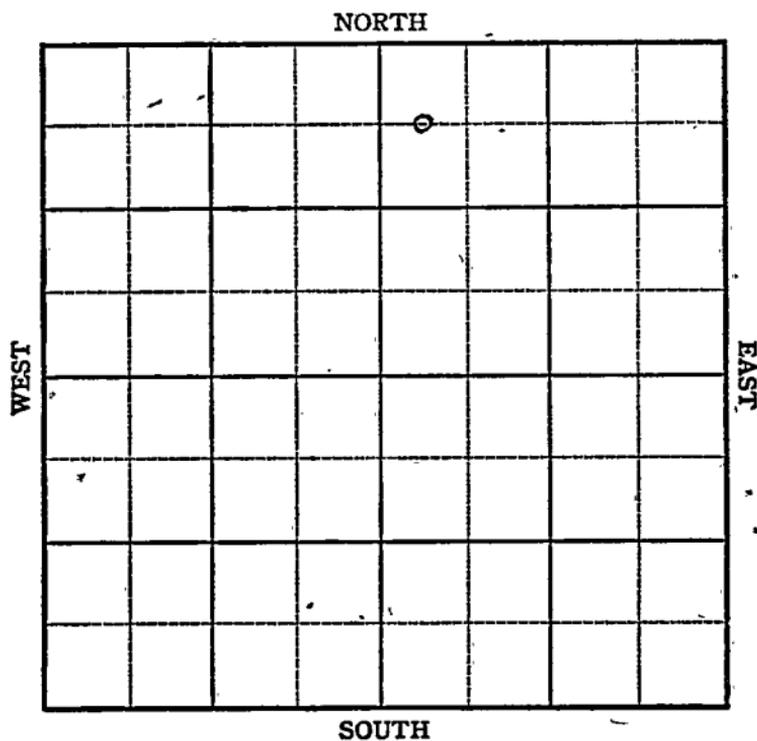

KANSAS

Sec. 29 Twp. 31 R. 14-W

Well No. #3 Skinner "B" Farm _____


Deep Rock Company
Skinner Pool

660 Ft. from N. Line

_____ Ft. from S. Line

_____ Ft. from E. Line

330 Ft. from W. Line

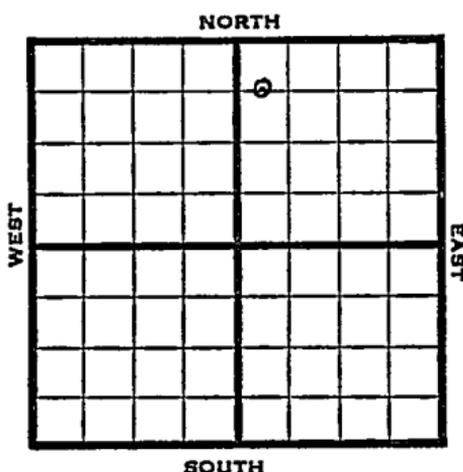

C W L NW NE

1947 1736 REPORT

2/26 Surface hole

3/4 8" @ 1082'
Drlg 1440'

3/11 Drlg 3775'

3/18 Drlg 3875'

3/25 Wap 4499'
Drlg 4546'

4/2 7" @ 4501 Rust

4/9 1500 Acid no shows
Drlg. 4538'.

4/15 TD 4590'

4/23 4620 fsg

4/29 " "

5/7 PB 4528'
7000 Acid
Pump 22 bbls. oil & 22 W a day

OVER

10 1100

5/14

Wag 4499'

72 @ 4501'

7000 Acid

Pump 27 Oil / 16 W pot

39.0 Gr.

TD 4620'

COMPLETED

Kansas **KANSAS**

Map No. 93 Sec. 29 Twp. 31 R. 14W

Well No. 3 Skinner "B"

Deep Rock Company

FIRST REPORT

Contractor

C W L NW NE

SECTION PLAT

660 Ft. from N. Line
 Ft. from S. Line
 Ft. from E. Line
330 Ft. from W. Line

		o	

Barber County

Location _____
 Rig up _____
 Drilling and Remarks:
 surface hole

RECORD

Cased _____ in., _____ ft.
 Sand _____
 Gas _____
 Oil _____
 Total Depth _____

PRODUCTION

1st 24 hrs. Nat. _____
 1st 24 hrs. after shot _____
 Gas _____ Cu. Ft.
 Dry Hole _____
 Abandoned _____

Date

FEB 26 1947 19

S. J. LEWIS Scout

Misc Small Maps

Cards *Wes*

Tracing *Wes*

France Map

Scarborough Map

Pierce Map

Geological Dept.

Pierce Flat Book

Form 26 200 Bks. 10-46 Petrol
Kansas

Skinner Pool

Map No. 153 Sec. 29 Twp. 31 R. 14W

Well No. 3 Skinner "B"

Deep Rock

Company

COMPLETE

Contractor

C W L NW NE

2/1/236
SECTION PLAT

660 Ft. from N. Line

_____ Ft. from S. Line

_____ Ft. from E. Line

330 Ft. from W. Line

		6	

Barber County

RECORD

Location _____

Cased _____ in., _____ ft.

Rig up _____

Sand _____

Drilling and Remarks:

Gas _____

Oil _____

Total Depth 4520

Magj 4499
7/104501
Pump 27 oil 7/16 W
ST
29° 2/4

PRODUCTION

1st 24 hrs. Nat. _____

1st 24 hrs. after shot _____

Gas _____ Cu. Ft.

Dry Hole _____

Abandoned _____

Date

MAY 14 1947

S. J. LEWIS Scout

HELIX

Misc. Small Maps

Cards

Tracing

France Map

Scarborough Map

Pierce Map

Ceological Dept.

Pierce Flat Book