

KANSAS

Barber


FORM 51 JOM 12-46 PETROL

Section 29 Township 31 Range 14-W

Well No. 5 Skinner "B"

Company Deep Rock

Skinner Pool NORTH

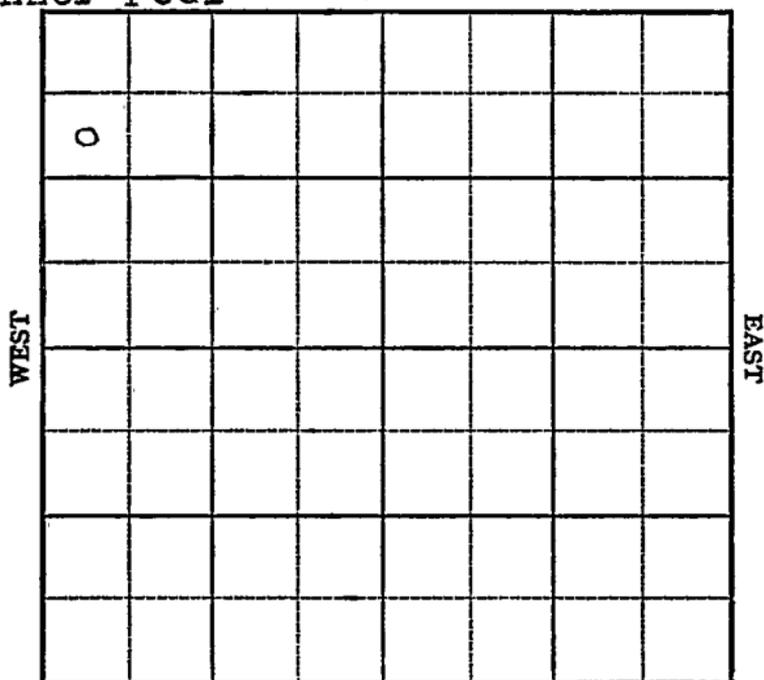

SOUTH

Sec. 29 Twp. 31 R. 14W

Well No. #5 Skinner "B" Farm

Deep Rock Company

Skinner


990 Ft. from N. Line

_____ Ft. from S. Line

_____ Ft. from E. Line

330 Ft. from W. Line

SW NW NW

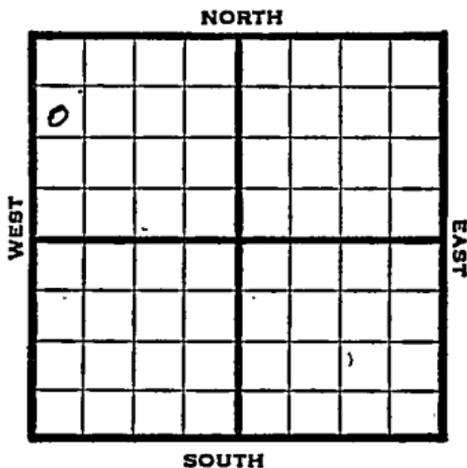

1947

Elev. 1800' REPORT

9/17 Location

9/24 "

10/1 RÜR

10/8 10" @ 280'
Drlg. 2130'

10/15 Drlg. 3608'

10/22 Viola 4567 TD 4569

10/29 7" @ 4569'
TD 4578'
Swb 5 bbls oil 1 hr.

11/5 Swb 7 bbls oil PH, 4 hrs
3000 Acid

11/12 5000 acid.
Pump & Flow 1050 bbls. oil.

11/19 Viola 4567'
8" @ 4569'
3500 acid
Bom & pot 2231'
39.0 Gr.
TD 4578'

COMPLETED

Map No. _____ Sec. 29 Twp. 31 R. 14W

Well No. 5 Skinner "B"

Deep Rock _____ Company

FIRST REPORT

Contractor _____

SW NW NW


SECTION PLAT

990 Ft. from N. Line

_____ Ft. from S. Line

_____ Ft. from E. Line

330 Ft. from W. Line

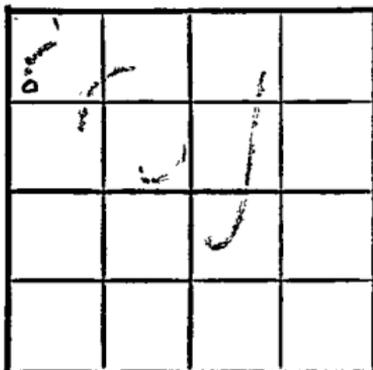

Barber County

Location X

Rig up _____

Drilling and Remarks:

RECORD

Cased _____ in., _____ ft.

Sand _____

Gas _____

Oil _____

Total Depth _____

PRODUCTION

1st 24 hrs. Nat. _____

1st 24 hrs. after shot _____

Gas _____ Cu. Ft.

Dry Hole _____

Abandoned _____

Date

SEP 17 1947 19

S. J. LEWIS Scout

Map No. 93 Sec. 29 Twp. 31 R. 14W

Well No. 5 Skinner "B"

Deep Rock Company

COMPLETE

Contractor

SW NW NW

E 1,1800
SECTION PLAT

990 Ft. from N. Line

_____ Ft. from S. Line

_____ Ft. from E. Line

330 Ft. from W. Line

Barber County

Location _____

Rig up _____

Drilling and Remarks:

Vista 4567

7" @ 4569

3500 acid

Bonded 2231

3.9 3/4

RECORD

Cased _____ in., _____ ft.

Sand _____

Gas _____

Oil _____

Total Depth *4578*

PRODUCTION

1st 24 hrs. Nat. _____

1st 24-hrs. after shot _____

Gas _____ Cu. Ft.

Dry Hole _____

Abandoned _____

Date

NOV 1 9 1947 19

S. J. LEWIS Scout