

KANSAS


Barber County

O.W.D.D

Section 29 Township 31 Range 14W

Well No. 1 H.W. Skinner "B"

Company Deep Rock

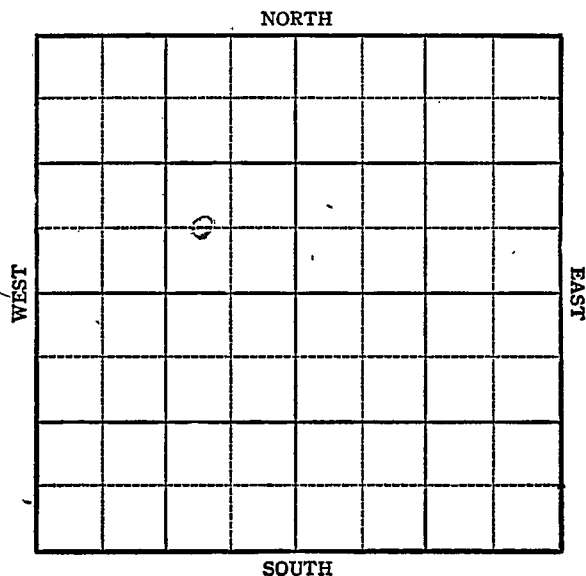

KANSAS

Barber O.W.D.D.
31 14W ✓

Sec. 29 Twp. 31 R. 14W

Well No. #1 H W Skinner "B" Farm

Deep Rock

Company

Patton - Contr.

Skinner

NORTH


Ft. from N. Line

660' Ft. from S. Line

990' Ft. from E. Line

Ft. from W. Line

Elev. 1798

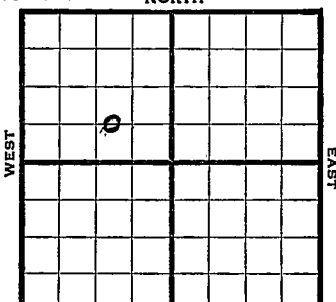

1944

Elev. 1789' REPORT

6/28

Location

7/12

"

7/19

"

7/26

"

8/2

"

8/9

Cellar

8/16

"

8/23

"

8/30

13" @ 275 WOC

9/8

Drlg. 2285'

9/13

Drlg. 2400

9/21

Drlg. 3330

9/28

Drlg. 3505

10/4

Drlg. 4090

10/b1

Topeka 3098

Heebner 3760

Douglas 3950

Lans 3972 VSSO 4320

Drlg. 4530

10/18

Viola 4571-74 TD

Sat. 7" @ 4570 RUST

10/25

TD 4582

swb 89 oil in 23 hrs.

OVER

1944

11/8 Viola 4571
7" @ 4570
1000 acid
Flow 459 Pot.
TD 4582
Grav. 39.

COMPLETED

O.W.D.D

1953

9/9 Lans 3972, Viola 4571
OTD 4582'
7" @ 4570'
MIR to DD

11/4 D&A
TD 4840'
Lans 3972', Viola 4571'
OTD 4582'
7" @ 4570
Arb. 4827'
DST 4829-35, opn $\frac{1}{2}$ hrs., rec. 10'
socm, 1275#
DST 4830-40, opn 1 hr., rec. 20'
socm, 20' wcm, 20' sw, 1590#
SP 4550
Simp. 4717'
D&A

ABANDONED

KANSAS

Pool Name SkinnerMap No. 93 Sec. 29 Twp. 31 R. 14WWell No. 1 H. W. Skinner "B"Deep Rock


Company

FIRST REPORT

Contractor

C W L SE NW

SECTION PLAT

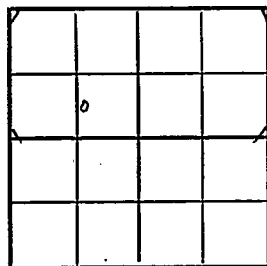

Ft. from N. Line

660

Ft. from S. Line

990

Ft. from E. Line

Ft. from W. Line

Barber CountyLocation X

Rig up

Drilling and Remarks:

RECORD

Cased _____ in., _____ ft.

Sand _____

Gas _____

Oil _____

Total Depth _____

PRODUCTION

1st 24 hrs. Nat. _____

1st 24 hrs. after shot _____

Gas _____ Cu. Ft.

Dry Hole _____

Abandoned _____

Date

JUN 28 1944

19

S. J. LEWIS

Scout

Misc. Small Maps

Cards

Tracing

France Map

Scarborough Map

Moody Map

Geological Dept.

Moody Plat Book

Ona

Betty

NE L

[Signature]

Pool Name SkinnerMap No. 93 Sec. 29 Twp. 31 R. 14 WWell No. 1 H. W. Skinner "B"Deep Rock

Company

COMPLETED

Contractor

C W L SE NW

SECTION PLAT

	b		

 Ft. from N. Line660 Ft. from S. Line990 Ft. from E. Line Ft. from W. LineBarberLocation Rig up

Drilling and Remarks:

Viola 45717" @ 45701000 acidFlow 459 Pst392 gr

RECORD

Cased in., ft.Sand Gas Oil Total Depth 4582

PRODUCTION

1st 24 hrs. Nat. 1st 24 hrs. after shot Gas Cu. Ft.Dry Hole Abandoned

Date

NOV 8 194419S. J. LEWIS Scout

Misc. Small Maps

Cards

Tracing

France Map

Scarb rough Map

Moody Map

Geological Dept.

Moody Plat Book

Leid

Betty
M. P.

Leid

O. W. D. D

County Barber State KansasSec. 29 (Blk. 31 (Sur. 14W Map No. 14W) (Rge.)Operator Deep RockWell No. 1 Farm Skinner "B"Elev. 1789 Location C W L SE NW

FIRST REPORT

660 Ft. From S Line NW990 Ft. From E Line Quarter1st. Report SEP 9. 1953Completion O. W. D. DRemarks (OWDD)

Patton - Contr.

Spudding Date

Drlg. Data Skinner Ranch Pool

Lans. 3972 Viola 4571 OTD 4582

7" @ 4570 WTR to DD

J. G. McGEHEE

SEP 11 1953

it Card

and

French

France Map

Pierce Map


Misc.

5

Drig. Data

O. W. D. D

County Barber State Kansas
 Sec. 29 (Blk. Twps.) 31 (Sur. Rgs.) 14W Map No.
 Operator Deep Rock
 Well No. 1 Farm Skinner "B"
 Elev. 1789 Location C W L SE NW

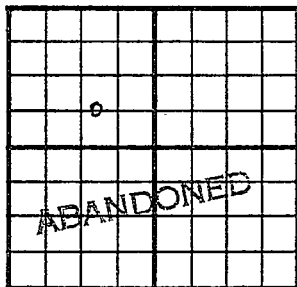

660 Ft. From S Line NW
990 Ft. From E Line Quarter

1st. Report

Completion NOV 4 1953

Remarks

OWDD

Spudding Date

O. W. D. D

Drig. Data D & A TD 4840Lans. 3972 Viola 4571 OTD 45827" @ 4570 Arb. 4827 DST 4829-35open $\frac{1}{2}$ hr. Rec. 10' socm 1275#DST 4830-40 open 1 hr. Rec. 20' socm20' wcm 20' sw 1590# SP 4550Simp. 4717D & A

J. G. McGEHEE

NOV 10 1953

Scout Cards	_____
Land Small Map	_____
Land Wall Map	_____
Tracings	_____
Finance Map	_____
Place Map	_____
Misc.	_____

Orig. Data