


Section 29 Township 31 Range 15W

Well No. #1 Schumacher

Company Prime Drlg. et al

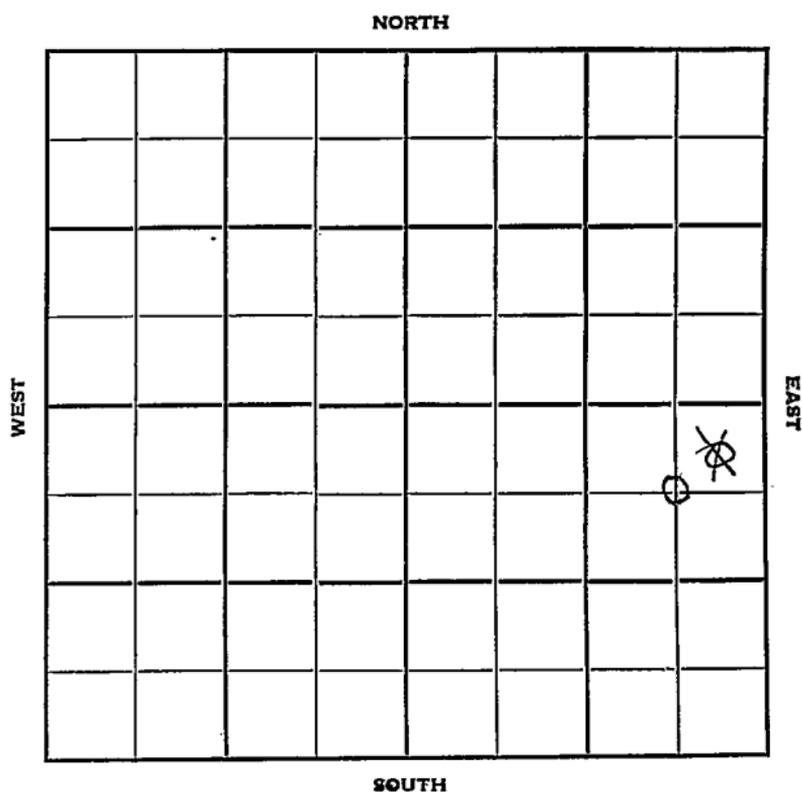

Barber

KANSAS

Sec. 29 Twp. 31 R. 15W

Well No. #1 Schumacher Farm

Prime Drlg. et al Company

Contractor

Wildcat


660
~~330~~ Ft. from N. Line

Ft. from S. Line

660
~~330~~ Ft. from E. Line

Ft. from W. Line

~~CNE SE~~
~~NE NE SE~~

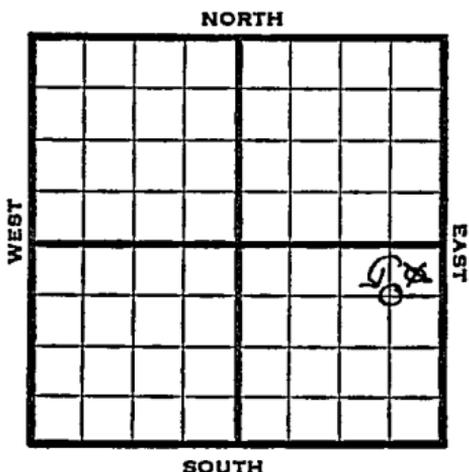

1951

Elev. 1950' REPORT

10/31

Location

12/5

Spud 10-19-51

D & A TD 5240' 8" @ 295'

Top. 3290' Doug. 4084'

Lans. 4200' Miss 4764' Viola 4906'

Simp. 5080' Arb. 5191-5240' TD

D & A

ABANDONED

Map No. _____ Sec. 29 Twp. 31 R. 15W

Well No. 1 Schumacher

Prime Drlg. _____ Company _____

CONFECTION Contractor _____

G NE SE

SECTION PLAT

660 Ft. from N. Line

_____ Ft. from S. Line

660 Ft. from E. Line

_____ Ft. from W. Line

			o

Barber County

Location _____

Rig up _____

Drilling and Remarks:

Reported

NE NE SE

RECORD

Cased _____ in., _____ ft.

Sand _____

Gas _____

Oil _____

Total Depth _____

PRODUCTION

1st 24 hrs. Nat. _____

1st 24 hrs. after shot _____

Gas _____ Cu. Ft.

Dry Hole _____

Abandoned _____

Date

NOV 14 1951 19

Scout

County Barber State Kansas

Sec. 29 (Blk. Twp.) 31 (Sur. Rge.) 15W Map No.

Operator Prime Drlg. etal.

Well No. 1 Farm Schumacher

Elev. 1950 Location C NE SE

ABANDONED

660' Ft. From N Line SE

660 Ft. From E Line Quarter

Ist. Report

Completion DEC 5 1951

Remarks Wildcat

Spudding Date 10-19-51

Drlg. Data D & A TD 5240

8" @ 295 Top. 3290 Doug. 4084

Lans. 4200 Miss. 4764 Viola 4906

Simp. 5080 Arb. 5191-5240 TD

D & A

J. E. TYRA