

Section 29 Township 31 Range 1W

Well No. 2 Hennigh

Company C. R. A.

Misc.

NORTH

WEST

EAST

SOUTH

KANSAS

Sumner



Sec. 29 Twp. 31 R. 1W

Well No. #2 Hennigh Farm

C R A

Company

Miscellaneous


1320' Ft. from N. Line

Ft. from S. Line

330' Ft. from E. Line

Ft. from W. Line

C E L NW

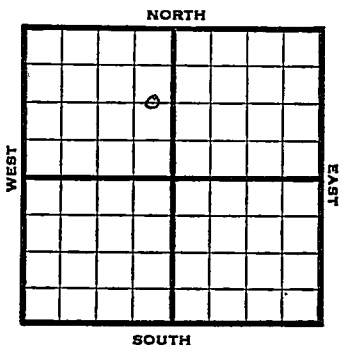

1948

Elev. 1277' REPORT

3/10

Location

3/17

"

3/24

10" @ 150'
Drilg. 2855'

3/31

Mississippi 3666'
TD 3668'
7" @ 3668'
RUST

4/7

"

4/14

"

4/21

"

4/28

"

5/5

"

5/12

Lansing 3047'
7" @ 3668'
Miss. 3666'
Pump 10 Pot
40.0 Gr.
TD 3693'
Comp.

COMPLETED

Map No. _____ Sec. 29 Twp. 31 R. 1W

Well No. 2 Hennigh

C R A _____ Company

FIRST REPORT _____ Contractor

C E L NW


SECTION PLAT

1320 Ft. from N. Line

_____ Ft. from S. Line

330 Ft. from E. Line

_____ Ft. from W. Line

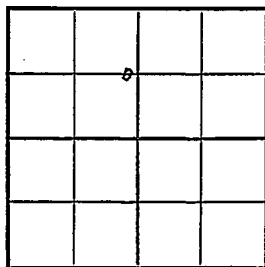

Summer County

Location X

Rig up _____

Drilling and Remarks:

RECORD

Cased _____ in., _____ ft.

Sand _____

Gas _____

Oil _____

Total Depth _____

PRODUCTION

1st 24 hrs. Nat. _____

1st 24 hrs. after shot _____

Gas _____ Cu. Ft.

Dry Hole _____

Abandoned _____

Date

MAR 10 1948 19 _____ S. J. LEWIS Scout

Map No. 31 Sec. 29 Twp. 31 R. 1W

Well No. 2 Hennigh

C R A


Company

COMPLETE

Contractor

C E L NW

E 1/2 29
SECTION PLAT

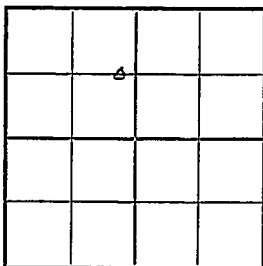

1320 Ft. from N. Line

Ft. from S. Line

330 Ft. from E. Line

Ft. from W. Line

Sumner County

Location

Rig up

Drilling and Remarks:

Lane 3047

2" C 3648

Misc 3666

Pump 10 B & F

40 C & L

RECORD

Cased in., ft.

Sand

Gas

Oil ✓

Total Depth 3623

PRODUCTION

1st 24 hrs. Nat.

1st 24 hrs. after shot

Gas Cu. Ft.

Dry Hole

Abandoned

Date

MAY 12 1948

19

S. J. LEWIS

Scout