


Section 29 Township 31 Range 1-W

Well No. 1 Ludwig


Company Shawver

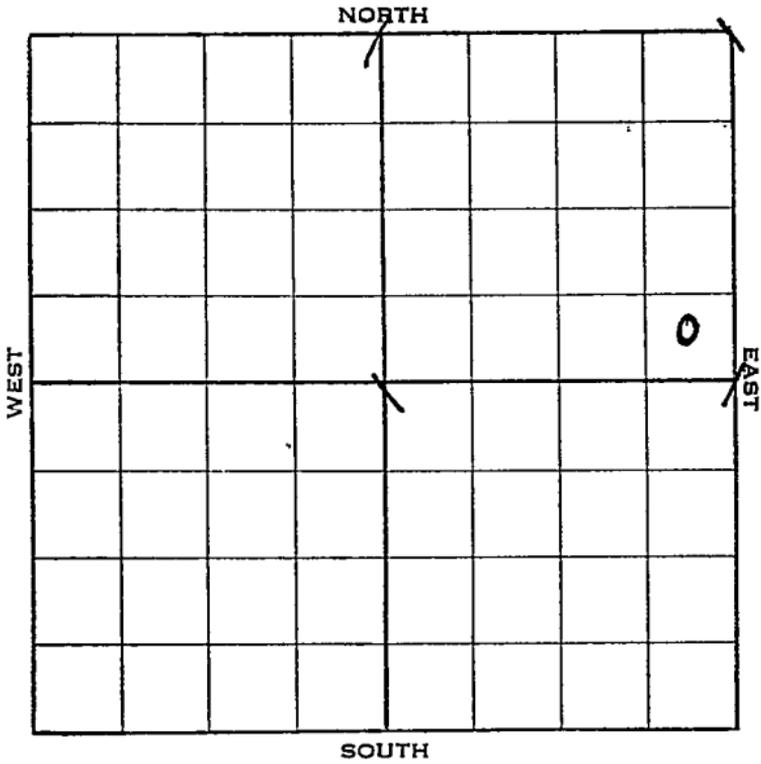

Sec. 29 Twp. 31 R. 1-W

Well No. #1 Ludwig Farm  
Shawver Company

\_\_\_\_\_ Ft. from N. Line  
330 Ft. from S. Line  
330 Ft. from E. Line  
 \_\_\_\_\_ Ft. from W. Line

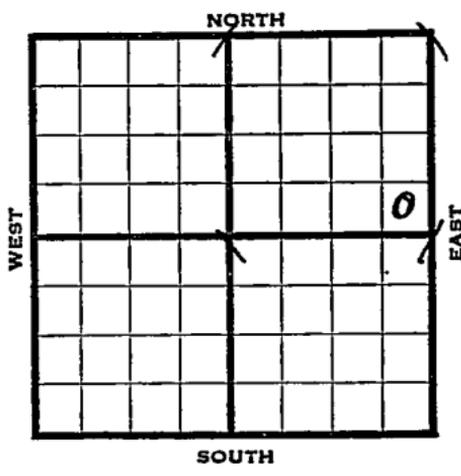

Elev. 1276'.

1938	REPORT
10/5	R U R
10/14	10" - 345'. WOC.
10/21	Dlg. 2150'.
10/28	Lans. 3042'. Dlg. 3290'.
11/4	Miss. 3662'. T. D. 3664'. 7" - 3664'. RUST.
11/12	S. G. 3672'. T. D. 3700'. Swab 50 oil per day. 1000 acid. Swab 8 oil per hour.
11/16	7" - 3664'. Miss. 3662'. T. D. 3700'. 5000 acid. Potential 630 bbls.
	COMPLETED



