


*Summer*

Form 51-5M-5-34-Palace

Map No. **KANSAS** Sec. *29* Twp. *31* R. *10*

Well No. *1 Gaskil* Farm  
*Shuover & Taylor* Company

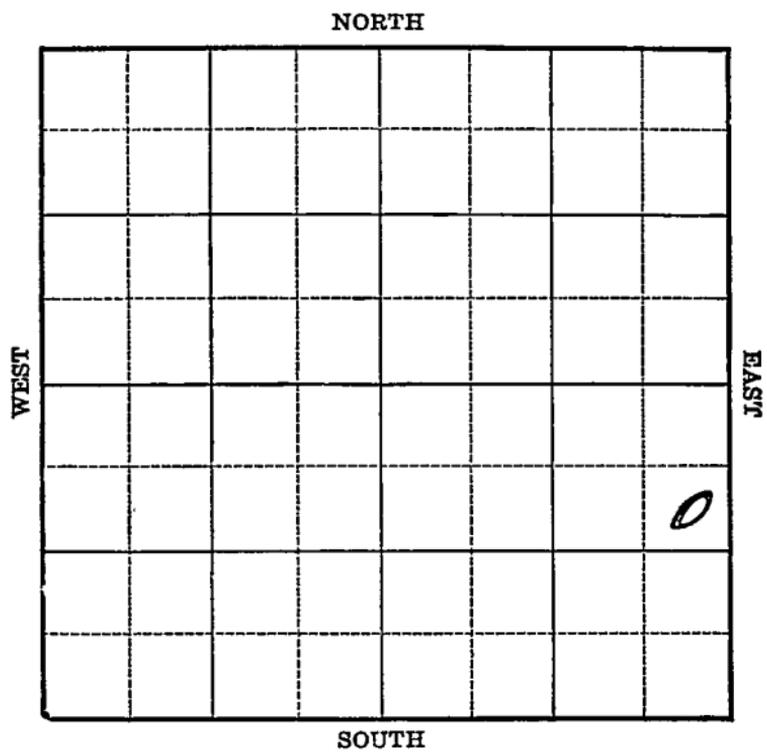

Location \_\_\_\_\_

Drilling Remarks \_\_\_\_\_

\_\_\_\_\_

\_\_\_\_\_

**RECORD**

Cased \_\_\_\_\_ in. \_\_\_\_\_ ft.

Sand \_\_\_\_\_

Gas \_\_\_\_\_

Oil \_\_\_\_\_

Total Depth \_\_\_\_\_

Rig Up \_\_\_\_\_

Drilling Remarks \_\_\_\_\_

\_\_\_\_\_

\_\_\_\_\_

**PRODUCTION**

1st 24 hrs. Nat. \_\_\_\_\_

1st 24 hrs. after shot \_\_\_\_\_

Gas \_\_\_\_\_ cu. ft. \_\_\_\_\_

Dry Hole \_\_\_\_\_


Abandoned \_\_\_\_\_

*Sumner*

Map No. KANSAS Sec. 29 Twp. 31 R. 1W

Well No. 1 Gaskil Farm  
Shover & Gyles Company

990 Ft. from N. Line  
\_\_\_\_ Ft. from S. Line  
330 Ft. from E. Line  
\_\_\_\_ Ft. from W. Line

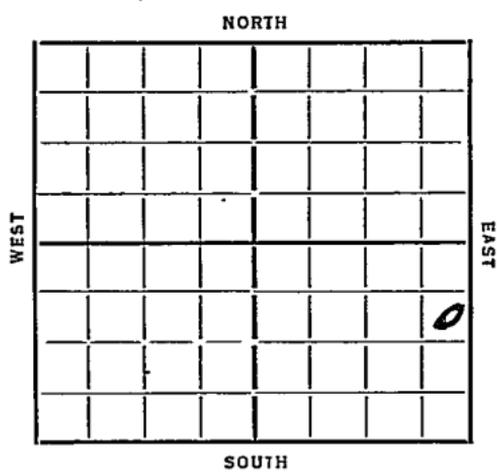

Date 1924

REPORT

<u>12/5</u>	<u>Location</u>	
<u>12/14</u>	<u>_____</u>	
<u>12/21</u>	<u>Rig &amp; tools</u>	
<u>12/27</u>	<u>Rig</u>	
<u>1/2/35</u>	<u>Dlg 320</u>	
<u>1/10</u>	<u>" 735</u>	
<u>1/17</u>	<u>" 1025</u>	
<u>1/24</u>	<u>" 1285</u>	
<u>1/31</u>	<u>" 1925</u>	<u>12" 1285</u>
<u>2/7</u>	<u>" 2400</u>	<u>10" 2027</u>
<u>2/14</u>	<u>Run 8" 2845</u>	
<u>2/21</u>	<u>Dlg 3196</u>	<u>6 1/4 3188</u>
<u>2/28</u>	<u>3550 SW</u>	
<u>3/7</u>	<u>5" 3688 WOC</u>	
<u>3/14</u>	<u>_____</u>	
<u>3/21</u>	<u>S.O. 3684-88 T Chat 3675</u>	
	<u>T 7 3714, 900' oil</u>	
<u>3/28</u>	<u>1000 acid</u>	
<u>4/4</u>	<u>58 Bbls oil residue</u>	
<u>4/10</u>	<u>Chat 3675 T 7 3714</u>	
	<u>1000 acid 183 Bbls.</u>	

COMPLETED

Map No. 31 Sec. 29 Twp. 31 R. 1W

Well No. 1- Gas kil

Shawnee & Texas Company

Contractor

**FIRST REPORTS**

**SECTION PLAT**

990 Ft. from N. Line

..... Ft. from S. Line

330 Ft. from E. Line

..... Ft. from W. Line

			0

Location

Rig up .....

Drilling and Remarks:

**RECORD**

Cased..... in., ..... ft.

Sand.....

Gas.....

Oil.....

Total Depth.....

**PRODUCTION**

1st 24 hrs. Nat.....

1st 24 hrs. after shot.....

Gas..... Cu. Ft.

Dry Hole.....

Abandoned.....

Date

12-5-37 192.....

ORVAL MANNSCHRECK  
Scout

Map No. 31 Sec. 29 Twp. 31 R. 1W

Well No. 1 - Maskil

Shaver & Texas Company

Contractor

**COMPLETED**

SECTION PLAT

990 Ft. from N. Line

..... Ft. from S. Line

330 Ft. from E. Line

..... Ft. from W. Line

			0

Location .....

Rig up .....

Drilling and Remarks:

1000 and

183  
ppp

RECORD

Cased          in.,          ft.

Sand Chat 3675

Gas .....

Oil .....

Total Depth 3714

PRODUCTION

1st 24 hrs. Nat. ....

1st 24 hrs. after shot .....

Gas .....

Cu. Ft.

Dry Hole .....

Abandoned .....

Date

4-10-35 192

ORVAL MANUSCRIPTS Scout