


Sumner

Section 29 Township 31 Range 1W

Well No. #3 Ludwig

Company Stelbar

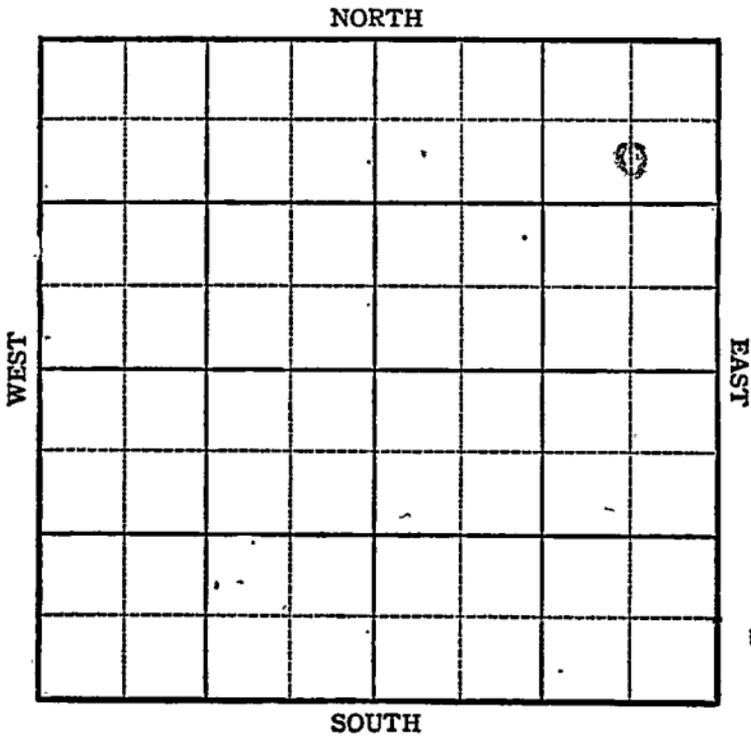

Summer

Sec. KANSAS Twp. 31 R. 1W

Well No. #3 Ludwig Farm  
Stelbar Company

Miscellaneous


990 Ft. from N. Line

\_\_\_\_\_ Ft. from S. Line

660 Ft. from E. Line

\_\_\_\_\_ Ft. from W. Line

*E. 1/2, 1279*

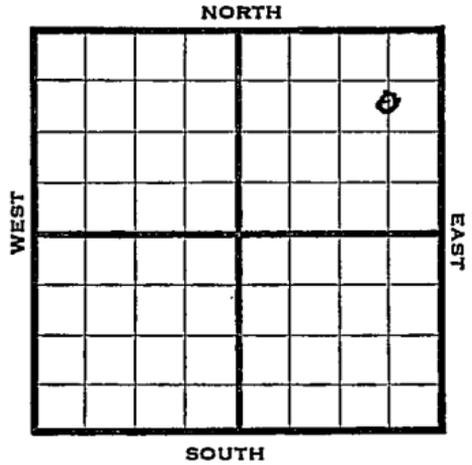

1944

REPORT

7/26

8" @ 342  
1948' Drlg.

8/2

K<sup>o</sup> 3060  
Miss 3671-75 TD  
5" @ 3675 RUST

8/9

TD 3710 Este 15 oil

8/16

" " " " "

8/23

" " " " "

8/30

" " " " "

9/8

" " " " "

9-13

Miss 3671  
5" @ 3675  
5000 acid  
Pump 80 Pot  
37.0 Gr.  
TD 3710

COMPLETED

Pool Name MiscellaneousMap No. KANSAS 2 Sec. 29 Twp. 31 R. 1WWell No. 3 LudwigStelbar CompanyFIRST REPORT Contractor

C S L N E N E

## SECTION PLAT

990 Ft. from N. Line

\_\_\_\_\_ Ft. from S. Line

660 Ft. from E. Line

\_\_\_\_\_ Ft. from W. Line

			o

Sumner County

Location \_\_\_\_\_

Rig up \_\_\_\_\_

Drilling and Remarks:

8" - 3421948

## RECORD

Cased \_\_\_\_\_ in., \_\_\_\_\_ ft.

Sand \_\_\_\_\_

Gas \_\_\_\_\_

Oil \_\_\_\_\_

Total Depth \_\_\_\_\_

## PRODUCTION

1st 24 hrs. Nat. \_\_\_\_\_

1st 24 hrs. after shot \_\_\_\_\_

Gas \_\_\_\_\_ Cu. Ft.

Dry Hole \_\_\_\_\_

Abandoned \_\_\_\_\_

Date

JUL 26 1944 19S. J. LEWIS Scout

