


Summer

Map No. KANSAS Sec. 29 Twp. 31 R. 1W

Well No. 2-Neal Farm _____
Shawver et al Company _____

_____ Ft. from N. Line
990 Ft. from S. Line
330 Ft. from E. Line
_____ Ft. from W. Line

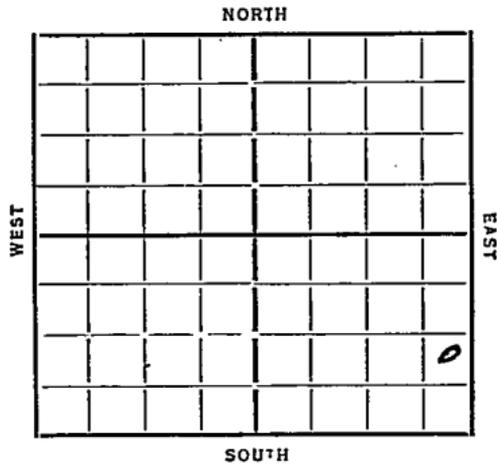

Date	REPORT
<u>1935</u>	
<u>3/30</u>	<u>Location</u>
<u>3/28</u>	<u>Ponds</u>
<u>4/4</u>	<u>Bldg.</u>
<u>4/11</u>	<u>—</u>
<u>4/18</u>	<u>dly 480 20' 49</u>
<u>4/24</u>	<u>" 3410</u>
<u>4/24</u>	<u>dly 1285 12" 1278</u>
<u>5/2</u>	<u>" 1820</u>
<u>5/9</u>	<u>" 2390</u>
<u>5/16</u>	<u>—</u>
<u>5/23</u>	<u>dly 2420</u>
<u>5/29</u>	<u>K C 3046 HFW 3080-89</u>
	<u>50 3165-68 6" 3385</u>
	<u>dly 3418</u>
<u>6/6</u>	<u>Chart 3660 U R 6"</u>
<u>6/13</u>	<u>6" 3663 P A P.</u>
<u>6/20</u>	<u>3700 T 17 1000 acid</u>
<u>6/28</u>	<u>testing</u>
<u>17/2</u>	<u>Chart 3660 T 17 3700</u>
	<u>1000 acid 225 Bbls</u>

COMPLETED

Map No. 31 Sec. 29 Twp. 31 R. 1W

Well No. 2-Neal

Shawver et al Company

Contractor

FIRST REPORTS

SECTION PLAT

..... Ft. from N. Line

990 Ft. from S. Line

330 Ft. from E. Line

..... Ft. from W. Line

			0

Location

Rig up

Drilling and Remarks:

RECORD

Cased in., ft.

Sand

Gas

Oil

Total Depth

PRODUCTION

1st 24 hrs. Nat.

1st 24 hrs. after shot

Gas Cu. Ft.

Dry Hole

Abandoned

Date

3-20-35 192.....

Scout

ORVAL MANUSCRIPTS

Map No. 31 Sec 29 Twp. 31 R. 1W

Well No. 2 Neal

Shawver et al Company

Contractor

~~EX-11111111~~

SECTION PLAT

			0

Ft. from N. Line

990 Ft. from S. Line

330 Ft. from E. Line

Ft. from W. Line

Location

Rig up

Drilling and Remarks:

1000 acid

225 bbl

RECORD

Cased in., ft.

Sand Chat 3660

Gas

Oil

Total Depth 3700

PRODUCTION

1st 24 hrs. Nat.

1st 24 hrs. after shot

Gas Cu. Ft.

Dry Hole

Abandoned

Date

7-2-35 192

ORVAL MANN-SCHRECK

Scout