

Section 29 Township 31 Range 1WWell No. 2 RiddellCompany C R A

Misc.

NORTH

WEST

EAST

SOUTH

Sec. 29 Twp. 31 R. 1-W ✓

Well No. #2 Riddell Farm

C R A

Company

Miscellaneous


990 Ft. from N. Line

 Ft. from S. Line

330 Ft. from E. Line

 Ft. from W. Line

SE NE SW

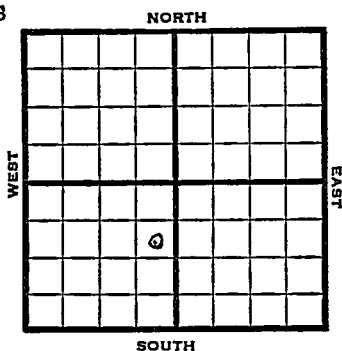

1948 Elev 1257' REPORT

1/3 RUR

11/10 8" @ 160'
Drlg 960'

11/16 Drlg. 3005'

11/23 KC 3031'
Mississippi 3640'-57'
TD 3657'
5" @ 3643'

11/30 "

12/6 "

12/14 "

12/22 PB

12/29 Miss 4325'
Drlg. 4375'

1949

1/12 TD 3690'
Miss 3648'
5" @ 3643'
4000 acid
Pump 48 oil Pot
407 Gr.
Comp

COMPLETED

Map No. _____ Sec. 29 Twp. 31 R. 1W

Well No. 2 Riddell

C R A _____ Company

FIRST REPORT _____ Contractor

SE NE SW


SECTION PLAT

990 Ft. from N. Line

_____ Ft. from S. Line

330 Ft. from E. Line

_____ Ft. from W. Line

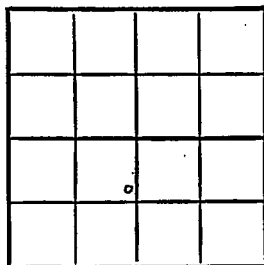

Sumner County

Location _____

Rig up _____

Drilling and Remarks:

R U R

RECORD

Cased _____ in., _____ ft.

Sand _____

Gas _____

Oil _____

Total Depth _____

PRODUCTION

1st 24 hrs. Nat. _____

1st 24 hrs. after shot _____

Gas _____ Cu. Ft.

Dry Hole _____

Abandoned _____

Date

NOV 3 1948 19

S. J. LEWIS

Scout

Map No. 31 Sec. 29 Twp. 31 R. 1WWell No. 2 Riddell

C R A

Company

COMPLETE

Contractor

SE NE SW

E. 1252


SECTION PLAT

990 Ft. from N. Line

Ft. from S. Line

330 Ft. from E. Line

Ft. from W. Line

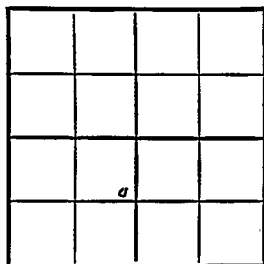

Sumner County

Location

Rig up

Drilling and Remarks:

*Misc 3648**5" Co 3643**4000 acid**Prod 48 Riddell**402 Gr*

RECORD

Cased _____ in., _____ ft.

Sand _____

Gas _____

Oil ☒Total Depth 8680

"PRODUCTION

1st 24 hrs. Nat. _____

1st 24 hrs. after shot _____

Gas _____ Cu. Ft.

Dry Hole _____

Abandoned _____

Date

JAN 12 1949 19

S. J. LEWIS

Scout