
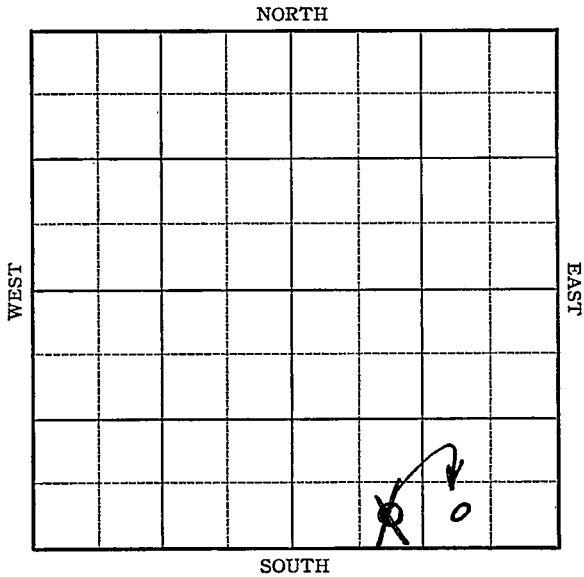


Sumner

KANSAS

Section 29 Township 31 Range 1-W
Well No. 4-NEAL
~~3-Neal~~
Company Stelbar

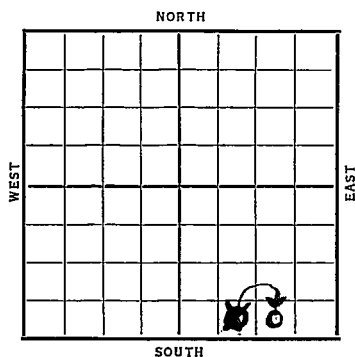

Sec. 29 Twp. 31 R. 1-WWell No. #3 Neal #4 FarmStelbar Company Ft. from N. Line330 Ft. from S. Line990 Ft. from E. Line990 Ft. from W. Line

Date

REPORT

1937

6/23 Cellar

7/2 10" @ 335'. WOC.

7/9 " " "

7/16 C.C. 3042'. Drlg. 3315'.

7/23 Chat & 7" @ 3656'. RUST.

7/30 T.D. 3707'. Swabbing 50 bbls. oil per day.

8/4 7" @ 3656'

Chat 3656'

TD 3707'

1000 acid

Pot. 141

Flowing

COMPLETED

Map No. 31 Sec. 29 Twp. 31 R. 1WWell No. 3-NealStelbar Company

Contractor

FIRST REPORT

SECTION PLAT

 Ft. from N. Line330 Ft. from S. Line Ft. from E. Line990 Ft. from W. Line

			0

Location Rig up

Drilling and Remarks:

Cellar

RECORD

Cased in., ft.Sand Gas Oil Total Depth

PRODUCTION

1st 24 hrs. Nat. 1st 24 hrs. after shot Gas Cu. Ft.Dry Hole Abandoned

Date

JUN 23 1937 19F. D. Hatfield Scout

Map No. 31 Sec. 29 Twp. 31 R. 1 ^WWell No. 4-NealStellar Company

Contractor

CORRECTION

 Ft. from N. Line330 Ft. from S. Line990 Ft. from E. Line712 Ft. from W. Line

SECTION PLAT

			0

Location Rig up

Drilling and Remarks:

First Reported as
#3 Neel & Loc
in SE SW SE

RECORD

Cased in., ft.Sand Gas Oil Total Depth

PRODUCTION

1st 24 hrs. Nat. 1st 24 hrs. after shot Gas Cu. Ft.Dry Hole Abandoned

Date

JUL 14 1937 19E. D. Hatfield Scout

KANSASMap No. 31 Sec. 29 Twp. 31 R. 1 WWell No. 4-NeelStelbar Company

Contractor

COMPLETED

SECTION PLAT

			0

_____ Ft. from N. Line

330 Ft. from S. Line990 Ft. from E. Line

_____ Ft. from W. Line

Location _____

Rig up _____

Drilling and Remarks:

1000 acidPot - 141flowing

RECORD

Cased 7 in., 3656 ft.Sand Chat 3656

Gas _____

Oil _____

Total Depth 3707

PRODUCTION

1st 24 hrs. Nat. _____

1st 24 hrs. after shot _____

Gas _____ Cu. Ft.

Dry Hole _____

Abandoned _____

Date

AUG 4 - 1937H. D. Hatfield Scout