

KANSAS

Barber

Form 51-5M-7-39-Palace


Section 29 Township 31 Range 11-W

Well No. #1 Whelen

Company Hylward Prod.
W. J. Coppinger et al

O. W. D. D

NORTH

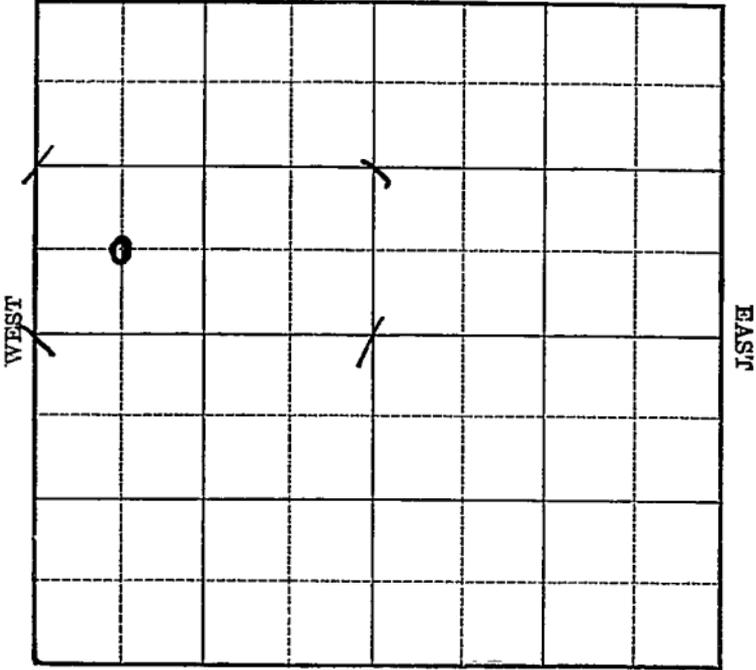

SOUTH

Sec. 29 Twp. 31 R. 11-W

Well No. #1 Whelan Farm
W. J. Coppinger et al Company


(Whelan)

_____ Ft. from N. Line

660 Ft. from S. Line

_____ Ft. from E. Line

660 Ft. from W. Line

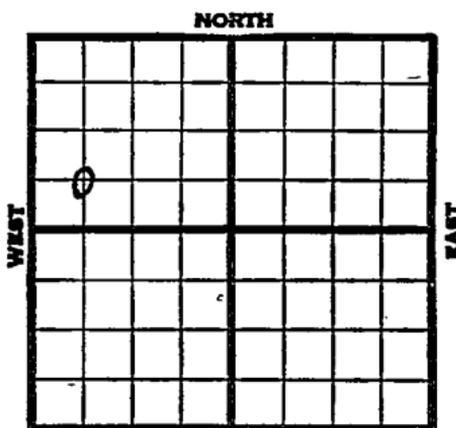

Elev. 1607

1940	O. W. R. R.	REPORT
1/24	Cellar.	
2/1	"	
2/8	Rotary.	
2/15	12 1/2" - 127'	WOC.
2/23	Drlg. 1835'	
2/29	Drlg. 3240'	
3/8	Lansing 3785'	
	Drlg. 4086'	
3/14	Chat. 4341'	SSO & G. 4351-57'
	5" - 4335'	RUST.
3/21	" " "	
3/28	T.D. 4385'	Flow 68 bbls. oil in 2 hours.
4/3	Chat. 4349'	
	5" - 4335'	
	T.D. 4385'	
	Flow 805 bbls., potential.	
	3 M cu. ft. gas.	
COMPLETED		
OVER		

1944

O. W. D. D .

8-23 OTD 4385'
Miss. 4339
5" @ 4335
TD 4387
Bomb Pot. 3188
Max. 3000
No Water
Gravity 31.6

FIRST REPORT

~~4~~
COMPLETED, .

Map No. 61 Sec. 29 Twp. 31 R. 11WWell No. 1 WhelenW. J. Coppinger etal Company

Contractor

FIRST REPORT

C SW NW

SECTION PLAT

o			

_____ Ft. from N. Line

660 Ft. from S. Line

_____ Ft. from E. Line

660 Ft. from W. Line

WHELAN POOL

Location _____

Rig up _____

Drilling and Remarks:

Cellar

RECORD

Cased _____ in., _____ ft.

Sand _____

Gas _____

Oil _____

Total Depth _____

PRODUCTION

1st 24 hrs. Nat. _____

1st 24 hrs. after shot _____

Gas _____ Cu. Ft.

Dry Hole _____

Abandoned _____

Date

11 2 1940

19

S. J. LEWIS

Scout

Misc. Small Maps

Cards

Tracing

France Map

Scarborough Map

Moody Map

Geological Dept.

Moody Flat Book

Map No. 61 Sec. 29 Twp. 31 R. 11WWell No. 1 WhelenW. J. Coppinger etal Company

Contractor

COMPLETED

C SW NW

 Ft. from N. Line660 Ft. from S. Line Ft. from E. Line660 Ft. from W. Line**SECTION PLAT**

WHELEN POOLLocation Rig up

Drilling and Remarks:

*Phat 4349
5" c 4385
Flow. 805 Pcy
3M Gas*

RECORDCased in., ft.Sand Gas Oil Total Depth 4385**PRODUCTION**1st 24 hrs. Nat. 1st 24 hrs. after shot Gas Cu. Ft.Dry Hole Abandoned

Date

APR 3 1940 19

S. J. LEWIS Scout

Misc. Small Maps
Cards
Tracing
France Map
Scarborough Map
Moody Map
Geological Dept.
Moody Flat Book


Pool Name Whelan

Map No. KANSAS Sec. 29 Twp. 31 R. 11W

Well No. 1 Whelan

Alyward Prod. Company

FIRST REPORT

and Contractor

C SW NW **COMPLETED**

SECTION PLAT

 Ft. from N. Line

660 Ft. from S. Line

 Ft. from E. Line

660 Ft. from W. Line

o			

Barber County OWJJI U. W. D. D.

Location

Rig up

Drilling and Remarks:

Misc 4339
5' @ 4335
6' @ 4335
Bonus P 43158
Mo 3000
No Water
315

RECORD

Cased in., ft.

Sand

Gas

Oil

Total Depth 4387

PRODUCTION

1st 24 hrs. Nat.

1st 24 hrs. after shot

Gas Cu. Ft.

Dry Hole

Abandoned

Date

AUG 2 3 1944 19

S. J. LEWIS Scout

Misc. Small Maps	<i>Reid</i>
Cards	<i>Leidy</i>
Tracing	<i>ML</i>
France Map	<input checked="" type="checkbox"/>
Scarborough Map	<i>Reid</i>
Moody Map	<input checked="" type="checkbox"/>
Geological Dept.
Moody Plat Book	