

PI

CONNECTED
(REV) ACC-1
12-31-82
Jml

SIDE ONE

AFFIDAVIT OF COMPLETION FORM

This form shall be filed in duplicate with the Kansas Corporation Commission, 200 Colorado Derby Building, Wichita, Kansas 67202, within ten days after the completion of the well, regardless of how the well was completed.

Attach separate letter of request if the information is to be held confidential. If confidential, only file one copy. Information on side one will be of public record and side two will then be held confidential.

Circle one: Oil, Gas, Dry, SWD, OWWO, Injection. Type and complete ALL sections. Applications must be filed for dual completion, commingling, SWD and injection, T.A.

Attach wireline logs (i.e. electrical log, sonic log, gamma ray neutron log, etc.).
KCC # (316) 263-3238. (Rules 82-2-105 & 82-2-125)

State Geological Survey
WICHITA BRANCH

OPERATOR Cuesta Energy Corporation

API NO. 15-191-21382

ADDRESS 1413 Park Harvey Center

COUNTY Sumner

Oklahoma City, OK 73102

FIELD n/a

**CONTACT PERSON Jerry Arthur

PROD. FORMATION n/a

PHONE (405) 232-4891

LEASE Osner "A"

PURCHASER n/a

WELL NO. 1

ADDRESS _____

WELL LOCATION NE-SE-SW

DRILLING Sunflower Drilling Partnership

2310 Ft. from West Line and

CONTRACTOR _____

990 Ft. from South Line of

ADDRESS P.O.Box 204

the SW/4 SEC. 12 TWP. 31S RGE. 3E W

Wichita, KS 67201


WELL PLAT

PLUGGING Allied Cementing Company, Inc.

CONTRACTOR _____

ADDRESS P.O.Box 678

Great Bend, KS 67530

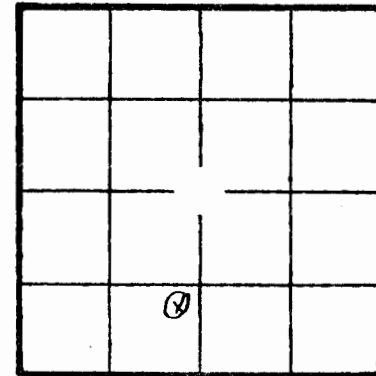

KCC
KGS
(Office Use)

TOTAL DEPTH 4340 PBTD _____

SPUD DATE 1-8-82 DATE COMPLETED 1-19-82

ELEV: GR 1314' DF _____ KB 1325'

DRILLED WITH ~~(CAMBER)~~ (ROTARY) ~~(AIR)~~ TOOLS

Amount of surface pipe set and cemented 336' DV Tool Used? No

A F F I D A V I T

STATE OF OKLAHOMA, COUNTY OF OKLAHOMA SS, I, _____

June Lauren Boyce OF LAWFUL AGE, BEING FIRST DULY SWORN UPON HIS OATH,

DEPOSES THAT HE IS Jerry Arthur (FOR)(OF) Cuesta Energy Corporation

OPERATOR OF THE Osner # "A" LEASE, AND IS DULY AUTHORIZED TO MAKE

THIS AFFIDAVIT FOR AND ON THE BEHALF OF SAID OPERATOR, THAT WELL NO. 1 ON

SAID LEASE HAS BEEN COMPLETED AS OF THE 19th DAY OF January, 19 82,

INFORMATION ENTERED HEREIN WITH RESPECT TO SAID WELL IS TRUE AND CORRECT.

RECEIVED
KANSAS CORPORATION COMMISSION