

KANSAS


FORM 51 5M BR1X

Barber

Section 3 Township 31 Range 14W

Well No. #1 Hargis

Company Dickey Oil

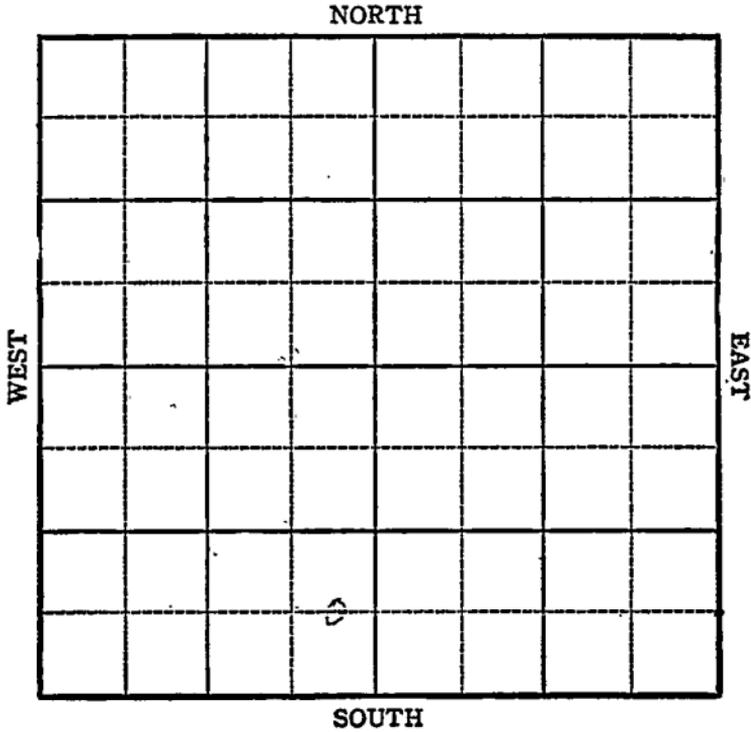

KANSAS

Barber

Sec. 3 Twp. 31 R. 14W

Well No. #1 Hargis Farm
Dickey Oil Company

Wildcat


NORTH

 Ft. from N. Line

660' Ft. from S. Line

330' Ft. from E. Line

 Ft. from W. Line

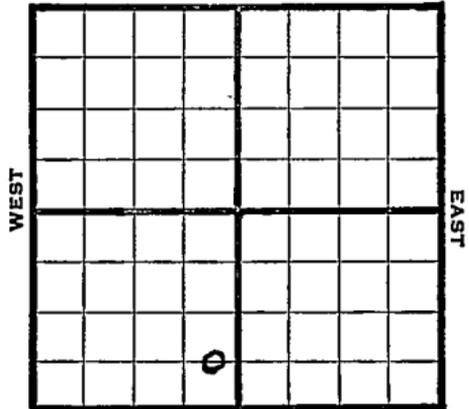

Elev. 1717

1944 Dry Hole Donations **REPORT**

- 6/21 Material
- 6/28 12" @ 204' 8" @ 808. Drlg. 960
- 7/10 Drilling 3655 (Telegram)
- 7/12 Top Lansing 3826. (Runs 20' higher than Huber gas well to southeast) (Telegram)
- 7/18 Topped Maquoketa 4399
Drilled to 4440
DST - Packer set 4400' showed gas thru 5/8" choke in 10 minutes. Open 25 Min. Estimated 2 to 3 Million gas. (Telegram)
- 7/25 Arbuckle 4631
TD 4681' no shows.
5" @ 4668'.
To perforate Lansing. (Tel)
- 8-3 Preparing to perforate Viola gas pay. (Telegram)
- 8-5 Perforated casing 4394-4417.
Preparing to test. (Telegram)
- 8-7 Wash with 500 acid.
Estimate 4 to 5 Million gas.
Will give it 3000-gallons acid (Telegram)
- 8-8 Re-acidized w/3000 gallons acid
Estimated 15,000,000 c.f. gas
Will take state guage tomorrow. (Telegram)

OVER

1944

8-11 Acidized w/5000 gallons acid instead of 3000 gallons as per telegram of 8-8-44.

Perforated 80 holes 4394-4417
Gas decreased to 3,800,000 with small spray oil.

Going to re-check samples.

Expect to perforate a little lower and to re-acidize. (Tel)

8-22 Acidized and the gas decreased.

Ran an electric-eye and found that all the acid had gone to the bottom of the hole instead of thru the perforations.

Will re-perforate 69 shots 4399-4407' and put a jelly seal on bottom, then will re-acidize. (Tel)

8-23 Acidize with 2000 gallons

8-30 Perf. 92 shots 4415-31
No increase.

9/13 Lans 3826'
Arb 4631
5" 4668'
92 shots 4415-4431
500 acid
TD 4681'
4 Mile gas
1500# Rock Pressure

COMPLETED

Pool Name Wildcat

Map No. 93 Sec. 3 Twp. 31 R. 14W

Well No. 1 Hargis

Dickey Oil Company


FIRST REPORT

Contractor

C E L S E S W

close on

SECTION PLAT

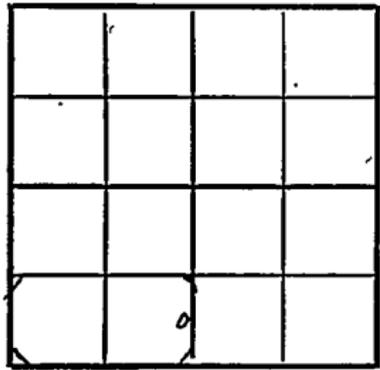

_____ Ft. from N. Line

660 Ft. from S. Line

330 Ft. from E. Line

_____ Ft. from W. Line

Barber County

Location _____

Rig up _____

Drilling and Remarks:

Material

RECORD

Cased _____ in., _____ ft.

Sand _____

Gas _____

Oil _____

Total Depth _____

PRODUCTION

1st 24 hrs. Nat. _____

1st 24 hrs. after shot _____

Gas _____ Cu. Ft.

Dry Hole _____

Abandoned _____

Date

JUN 21 1944 19


S. J. LEWIS Scout

1110

- Misc.. Small Maps *Own*
- Cards *Betty*
- Tracing *W. L.*
- France Map *V*
- Scarborough Map *W. L.*
- Moody Map *V*
- Geological Dept.
- Moody Plat Book

Pool Name WildcatMap No. 93 Sec. 3 Twp. 31 R. 14WWell No. 1. HargisDickey Oil CompanyCOMPLETED ContractorC E L S E S W

SECTION PLAT

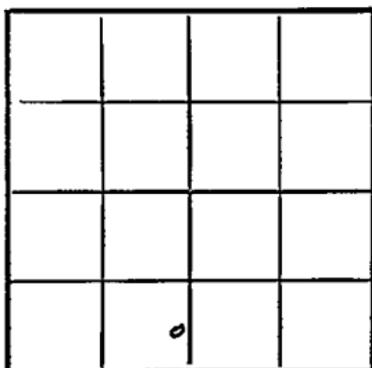 Ft. from N. Line660 Ft. from S. Line330 Ft. from E. Line Ft. from W. Line

Barber County

Location Rig up

Drilling and Remarks:

Loc 3826
Cr 4681
5" @ 4668
924 to 4415-31
500 acid
H.M. Gas
1500 # Roc 6 P

RECORD

Cased in., ft.Sand Gas Oil Total Depth 4681

PRODUCTION

1st 24 hrs. Nat. 1st 24 hrs. after shot Gas Cu. Ft.Dry Hole Abandoned

Date

SEP 13 1944 19S. J. LEWIS Scout

Misc. Small Maps	<i>Reid</i>
Cards	<i>ML</i>
Tracing	<i>ML</i>
France Map	<input checked="" type="checkbox"/>
Scarborough Map	<i>Reid</i>
Moody Map	<input checked="" type="checkbox"/>
Geological Dept.	
Moody Plat Book	