


Section 3 Township 31 Range 12W

Well No. 1 Haas

Company Bill Doenges

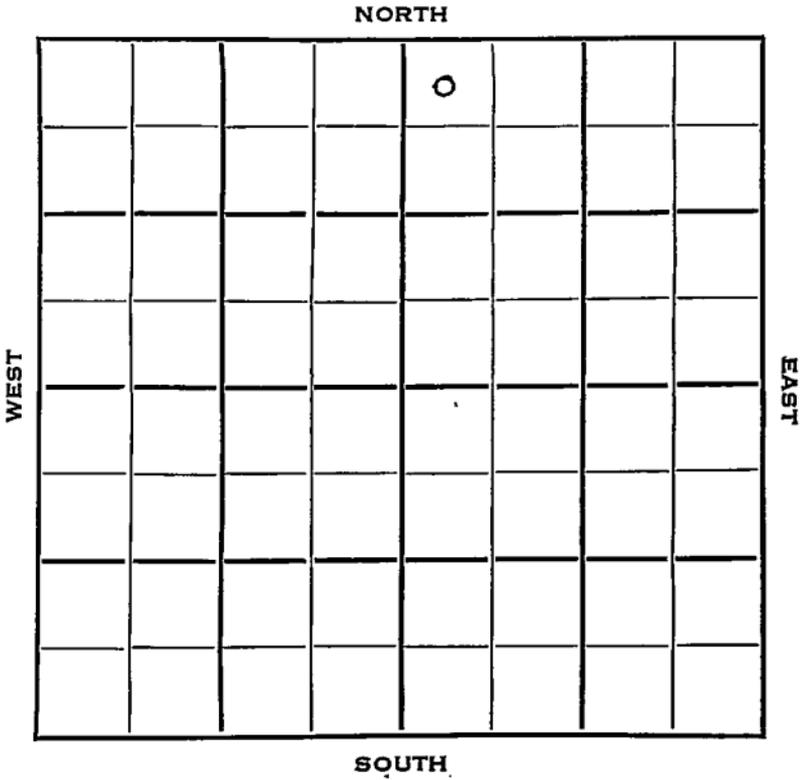

Sec. 3 Twp. 31 R. 12W

Well No. #1 Haas Farm

Bill Doenges Company

Coppinger Contractor

Wildcat


330 Ft. from N. Line

_____ Ft. from S. Line

_____ Ft. from E. Line

330 Ft. from W. Line

NW NW NE
CSO Farmout
Phillips - DHM

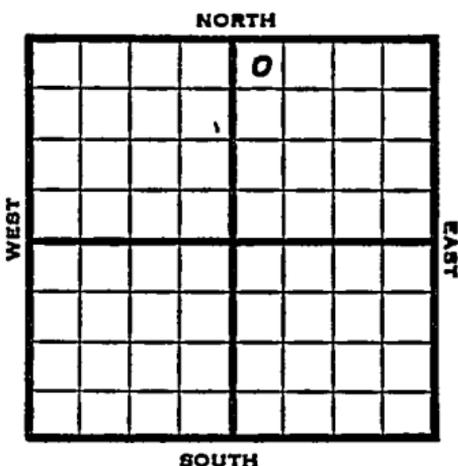

1953 Elev. 1652' REPORT

4/1 Spud 3-29-53
8" @ 380'

4/9 Tarkio 2825, Howard 3050, Top 3109
Drlg. 3267'

4/16 NR

4/23 "

4/29 Spud 3-29-53
D & A TD 4732
8" @ 380 Tarkio 2825 Howard 3050
Top 3109 Elgin Sd 3436 Heeb 3547
DST 3430-3500 open 40 min rec 10' mud
Doug 3575 Tonganoxie sd 3680
DST 3680-95 open 1 hr. rec 1320' SW
1350# Br lime 3735 Lans 3749
DST 4118-47 open 1 hr rec 30' mud &
VSSO 52# Miss 4239
DST 4240-54 open 1 hr rec 600' gas, 70'
SOEM 123# Kh 4349 Viola 4516
Simp 4574 Arb. 4692'
TD 4732 D & A

ABANDONED

