


Section 3 Township 31 Range 38 WWell No. # 1 DunneCompany Hugoton Prod.

NORTH

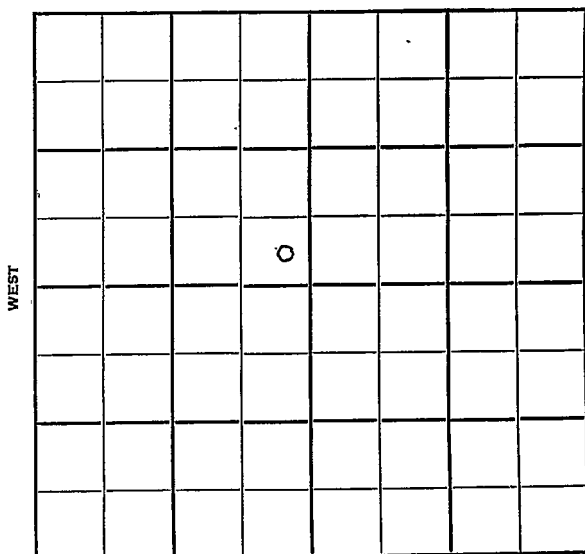

SOUTH

Stevens

KANSAS

Sec. 3 Twp. 31 R. 38 W

Well No. # 1 Dunne Farm

Hugoton Prod. Company

Moran Contractor

Hugoton Pool


2440 Ft. from N. Line

Ft. from S. Line

Ft. from E. Line

2440 Ft. from W. Line

SE NW

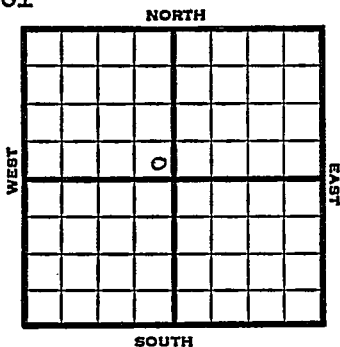

1951

Elev. 3136'

REPORT

4/18

Location


6/20

Spud 4-21-51 Gas well TD 2715'
10" @ 604 7" @ 2470' TD 2715'
Hol. 2432' Her. 2474' Krider 2493-
2557' Win. 2565-2608' Ft. Riley
2623-76' 19,000 A
Comp. 16,384,000 gas

COMPLETED

J. E. TYRA

County Stevens State Kansas
 Sec. 3 (Blk.) 31 (Sur.) 38W Map No.
 Operator Hugoton Prod.
 Well No. 1 Farm Dunne
 Elev. 3136 Location SE NW

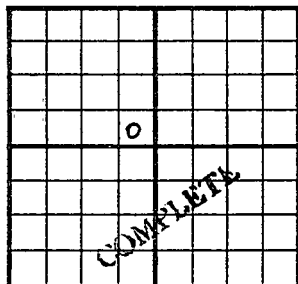

2440 Ft. From N Line NW

2440 Ft. From W Line Quarter

1st. Report

Completion JUN 20 1951

Remarks Hugoton Pool

Moran - Contr.

Spudding Date 4-21-51

Drlg. Data Gas well TD 2715

10" @ 604 7" @ 2470 TD 2715

Hor. 2432 Her. 2474 Krider 2493-2557

Win. 2565-2608 Ft. Riley 2623-76

19000 A Comp. 16,384,000 gas

J. E. TYRA