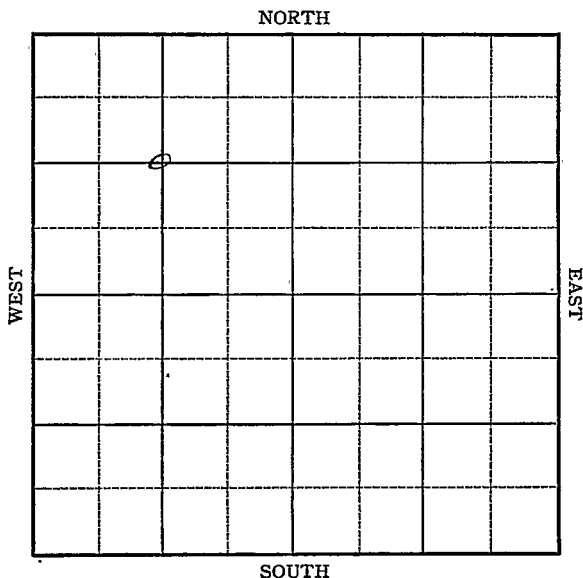


Section 3 Township 31 Range 37-WWell No. #1 ParsonsCompany Panhandle Eastern

Stevens KANSAS


Map No. MM Sec. 3 Twp. 31 R. 37WWell No. 1-ParsonsPanhandle Eastern CompanyContractor

FIRST REPORT

C NW

1320 Ft. from N. Line Ft. from S. Line Ft. from E. Line1320 Ft. from W. Line

SECTION PLAT

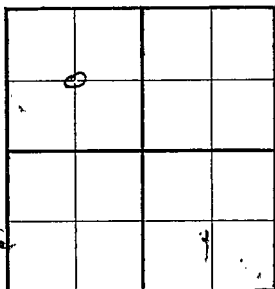Location Rig up Drilling and Remarks:
RUR

RECORD

Cased in., ft.Sand Gas Oil Total Depth

PRODUCTION

1st 24 hrs. Nat. 1st 24 hrs. after shot Gas Cu. Ft.Dry Hole Abandoned

Date

SEP 29 1937 19 H. D. Hatfield Scout

Stevens

KANSAS

Map No. _____ Sec. 3 Twp. 31 R. 37WWell No. 1 ParsonsPanhandle Eastern

Company

~~CONFIDENTIAL~~

Contractor

C NW


1320 Ft. from N. Line

_____ Ft. from S. Line

_____ Ft. from E. Line

1320 Ft. from W. Line

SECTION PLAT

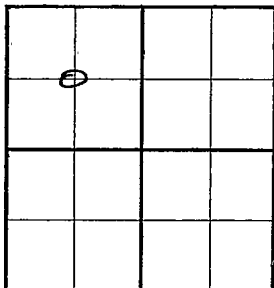

Location _____

Rig up _____

Drilling and Remarks:

*4000 acid**7 m gas*

RECORD

Cased 7 in., 2400 ft.Sand ?

Gas _____

Oil _____

Total Depth 2796

PRODUCTION

1st 24 hrs. Nat. _____

1st 24 hrs. after shot _____

Gas _____ Cu. Ft.

Dry Hole _____

Abandoned _____

Date

NOV 10 1937 19H. D. Hatfield Scout