


Section 3 Township 31 Range 36-W

Well No. 1 Gilbert

Company Magnolia

Hugoton Pool NORTH

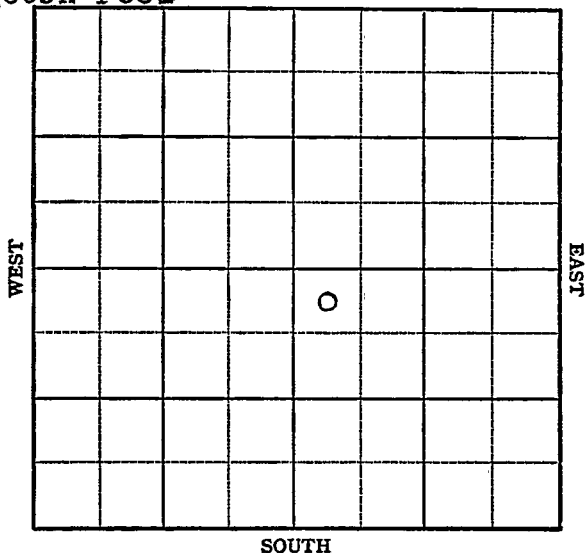

KANSAS Stevens

Sec. 3 Twp. 31 R. 36W

Well No. #1 Gilbert Farm

Magnolia Company

Hugoton


330 Ft. from N. Line

 Ft. from S. Line

 Ft. from E. Line

330 Ft. from W. Line

NW SE

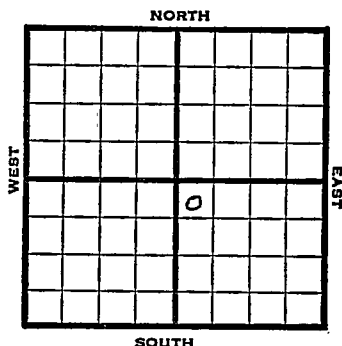

1947

REPORT

9/17 Location

9/24 10" @ 771'
WOC

10/1 Drlg. 2523'

10/8 7" @ 2725
TD 2726'

10/15 168 shots 2633-68 - 7000 Acid
168 " 2564-26 - " "
120 " 2525-52 - " "

10/22 "

10/29 Perf. , 21,000 acid., TD 2726'
10,100,000 CFGPD 400# R Pr.

COMPLETED

Map No. _____ Sec. 3 Twp. 31 R. 36W

Well No. 1 Gilbert

Magnolia Company

FIRST REPORT

Contractor _____

NW SE


SECTION PLAT

330 Ft. from N. Line

_____ Ft. from S. Line

330 Ft. from E. Line

330 Ft. from W. Line

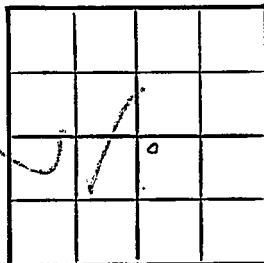

Stevens County

Location X

Rig up _____

Drilling and Remarks:

RECORD

Cased _____ in., _____ ft.

Sand _____

Gas _____

Oil _____

Total Depth _____

PRODUCTION

1st 24 hrs. Nat. _____

1st 24 hrs. after shot _____

Gas _____ Cu. Ft.

Dry Hole _____

Abandoned _____

Date

SEP 17 1947 19 _____ S. J. LEWIS Scout

Map No. 0 Sec. 3 Twp. 31 R. 36W

Well No. 1 Gilbert

Magnolia

Company

COMPLETE

Contractor

NW SE

E 12985


SECTION PLAT

330 Ft. from N. Line

_____ Ft. from S. Line

_____ Ft. from E. Line

330 Ft. from W. Line

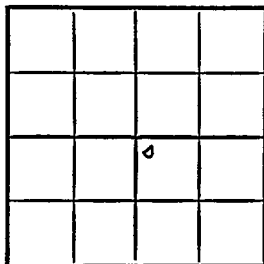

Stevens County

Location _____

Rig up _____

Drilling and Remarks:

7" @ 2725

Prof.

21,000 Prod

10,100,000 Gas

400 # R/P

RECORD

Cased _____ in, _____ ft.

Sand _____

Gas _____

Oil _____

Total Depth 2226

PRODUCTION

1st 24 hrs. Nat. _____

1st 24 hrs. after shot _____

Gas _____ Cu. Ft.

Dry Hole _____

Abandoned _____

Date

OCT 29 1947 19 S. J. LEWIS Scout